
City of	CORNER RECORD		Document Number 20080054		
			County of	PLACER , California	
		R MONUMENT FOR LOT	Г 82, Z MAPS 38 ((SEC. 7, T.10N., R.6E.)	
	57 TION RGE	CORNER TYPE Government Type Meander Rancho Date of Survey	Control	COORDINATES (Optional) N E Zone NAD27 NAD83 NAD83 NAD83 Epoch Vert. Datum: NGVD29 NAVD88 Meas. Units: Metric Imperial	
Corner -	Left as found	Found and tagged	Established	Reestablished 🛛 Rebuilt 🗌	
OF LOT 82 AS FOR RECORE WITH PLASTI	S SHOWN ON THAT O IN BOOK Z OF MA C CAP STAMPED L	CERTAIN FINAL MAP EN APS, AT PAGE 38, PLACER S 7944 AT 4.00 FOOT OFF condition of the monun	TITLED "TRACT # 9 R COUNTY RECORD SET ON LINE WAS	7944 IS IN GOOD CONDITION.	
This Corner Rother Land Survey	ecord was prepared	OR'S STATEMENT by me or under my directio OCTOBER 21 P.L.S. or R.C.E.	No. 7944	ith Stories E. Spirit Stories No. 7944 No. 7944 OF CALIFORNIA	
the Land Surve	ecord was prepared	by me or under my directio OCTOBER 21 P.L.S. or R.C.E. RVEYOR'S STATEMENT	No. 7944	ith Exp. 12/31/67 X No. 7944 X X X X X X X X X	

CORNER RECORD MORGAN CREEK VILLAGES 12/K LOT 82 - Z B.M. 38

COUNTY OF PLACER STATE OF CALIFORNIA

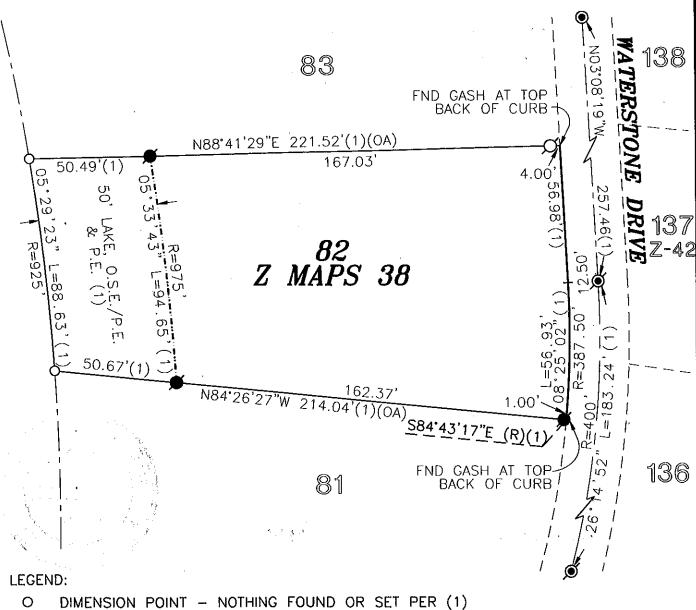

- SET 5/8" REBAR CAPPED L.S. 7944 Ø
- FOUND 5/8" REBAR CAPPED L.S. 6046 PER (1)
- FOUND CENTER PUNCHED COPPERWELD SURVEY (MONUMENT WELL STAMPED L.S. 6046 PER (1)
- FOUND CENTER PUNCHED COPPERWELD SURVEY Ø MONUMENT STAMPED L.S. 6046 PER (1)

FOUND FND

- Z MAPS 38 (1)
- RADIAL BEARING (R)
- (OA) **OVERALL**



SCALE: 1"=40'