


CORNER RECORD

Document Number _____

City of Granite Bay

County of Placer, California

Brief Legal Description The westerly corner of Lot 184, Lakeridge Subdivision No. 4, Book F of Maps, Page 39

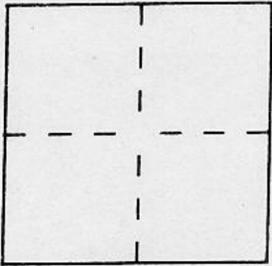

CORNER TYPE

Government Corner Control
 Meander Property
 Rancho Other
 Date of Survey 02/03/00

COORDINATES (Optional)

N. _____
 E. _____
 Zone _____ Datum _____
 Elev. _____

Corner — Left as found Found and tagged Established Reestablished Rebuilt

Identification and type of corner found: Evidence used to identify or procedure used to establish or reestablish the corner:
The westerly corner of Lot 184, Lakeridge Subdivision No. 4,

(Book F of Maps, Page 39) was re-established on this survey.

All other monuments for corners of Lot 184 were found as per said map.


A description of the physical condition of the monument as found and as set or reset: _____

Set a 1/2" rebar, 24 inches long, with plastic cap, LS4704, at the westerly corner of Lot 184.

SURVEYOR'S STATEMENT

This Corner Record was prepared by me or under my direction in conformance with the Land Surveyors' Act on 29 February ~~19~~ 2000

Signed David C. Hunter or R.C.E. Number 4704

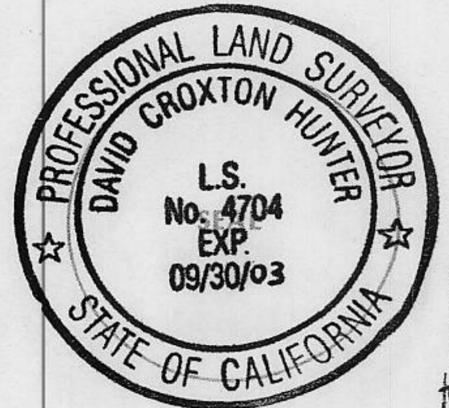


COUNTY SURVEYOR'S STATEMENT

This Corner Record was received May 30, 2000 and examined

and filed FEB 7 ~~19~~ 2001

Signed John H. Rietsjens Title County Surveyor

County Surveyor's Comment _____

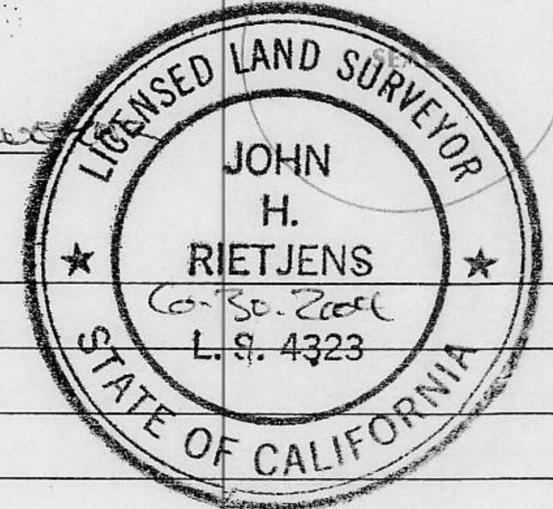

BOOK 6 CORNER RECORDS PAGE 88




REFERENCE INFORMATION

R1 BOOK F OF MAPS, PAGE 39

RECORD CURVE DATA:
I=10°56'00"
R=525.00'
L=100.18'
CB=N 34°59'40" E
LC=100.03'

SET 1/2" REBAR
24" LONG AND
PLASTIC CAP
LS 4704

BASIS OF BEARINGS
S 51°25'54" W - 391.40' M
S 59°42'10" E - 268.63' R
S 59°34'54" E - 269.29' M

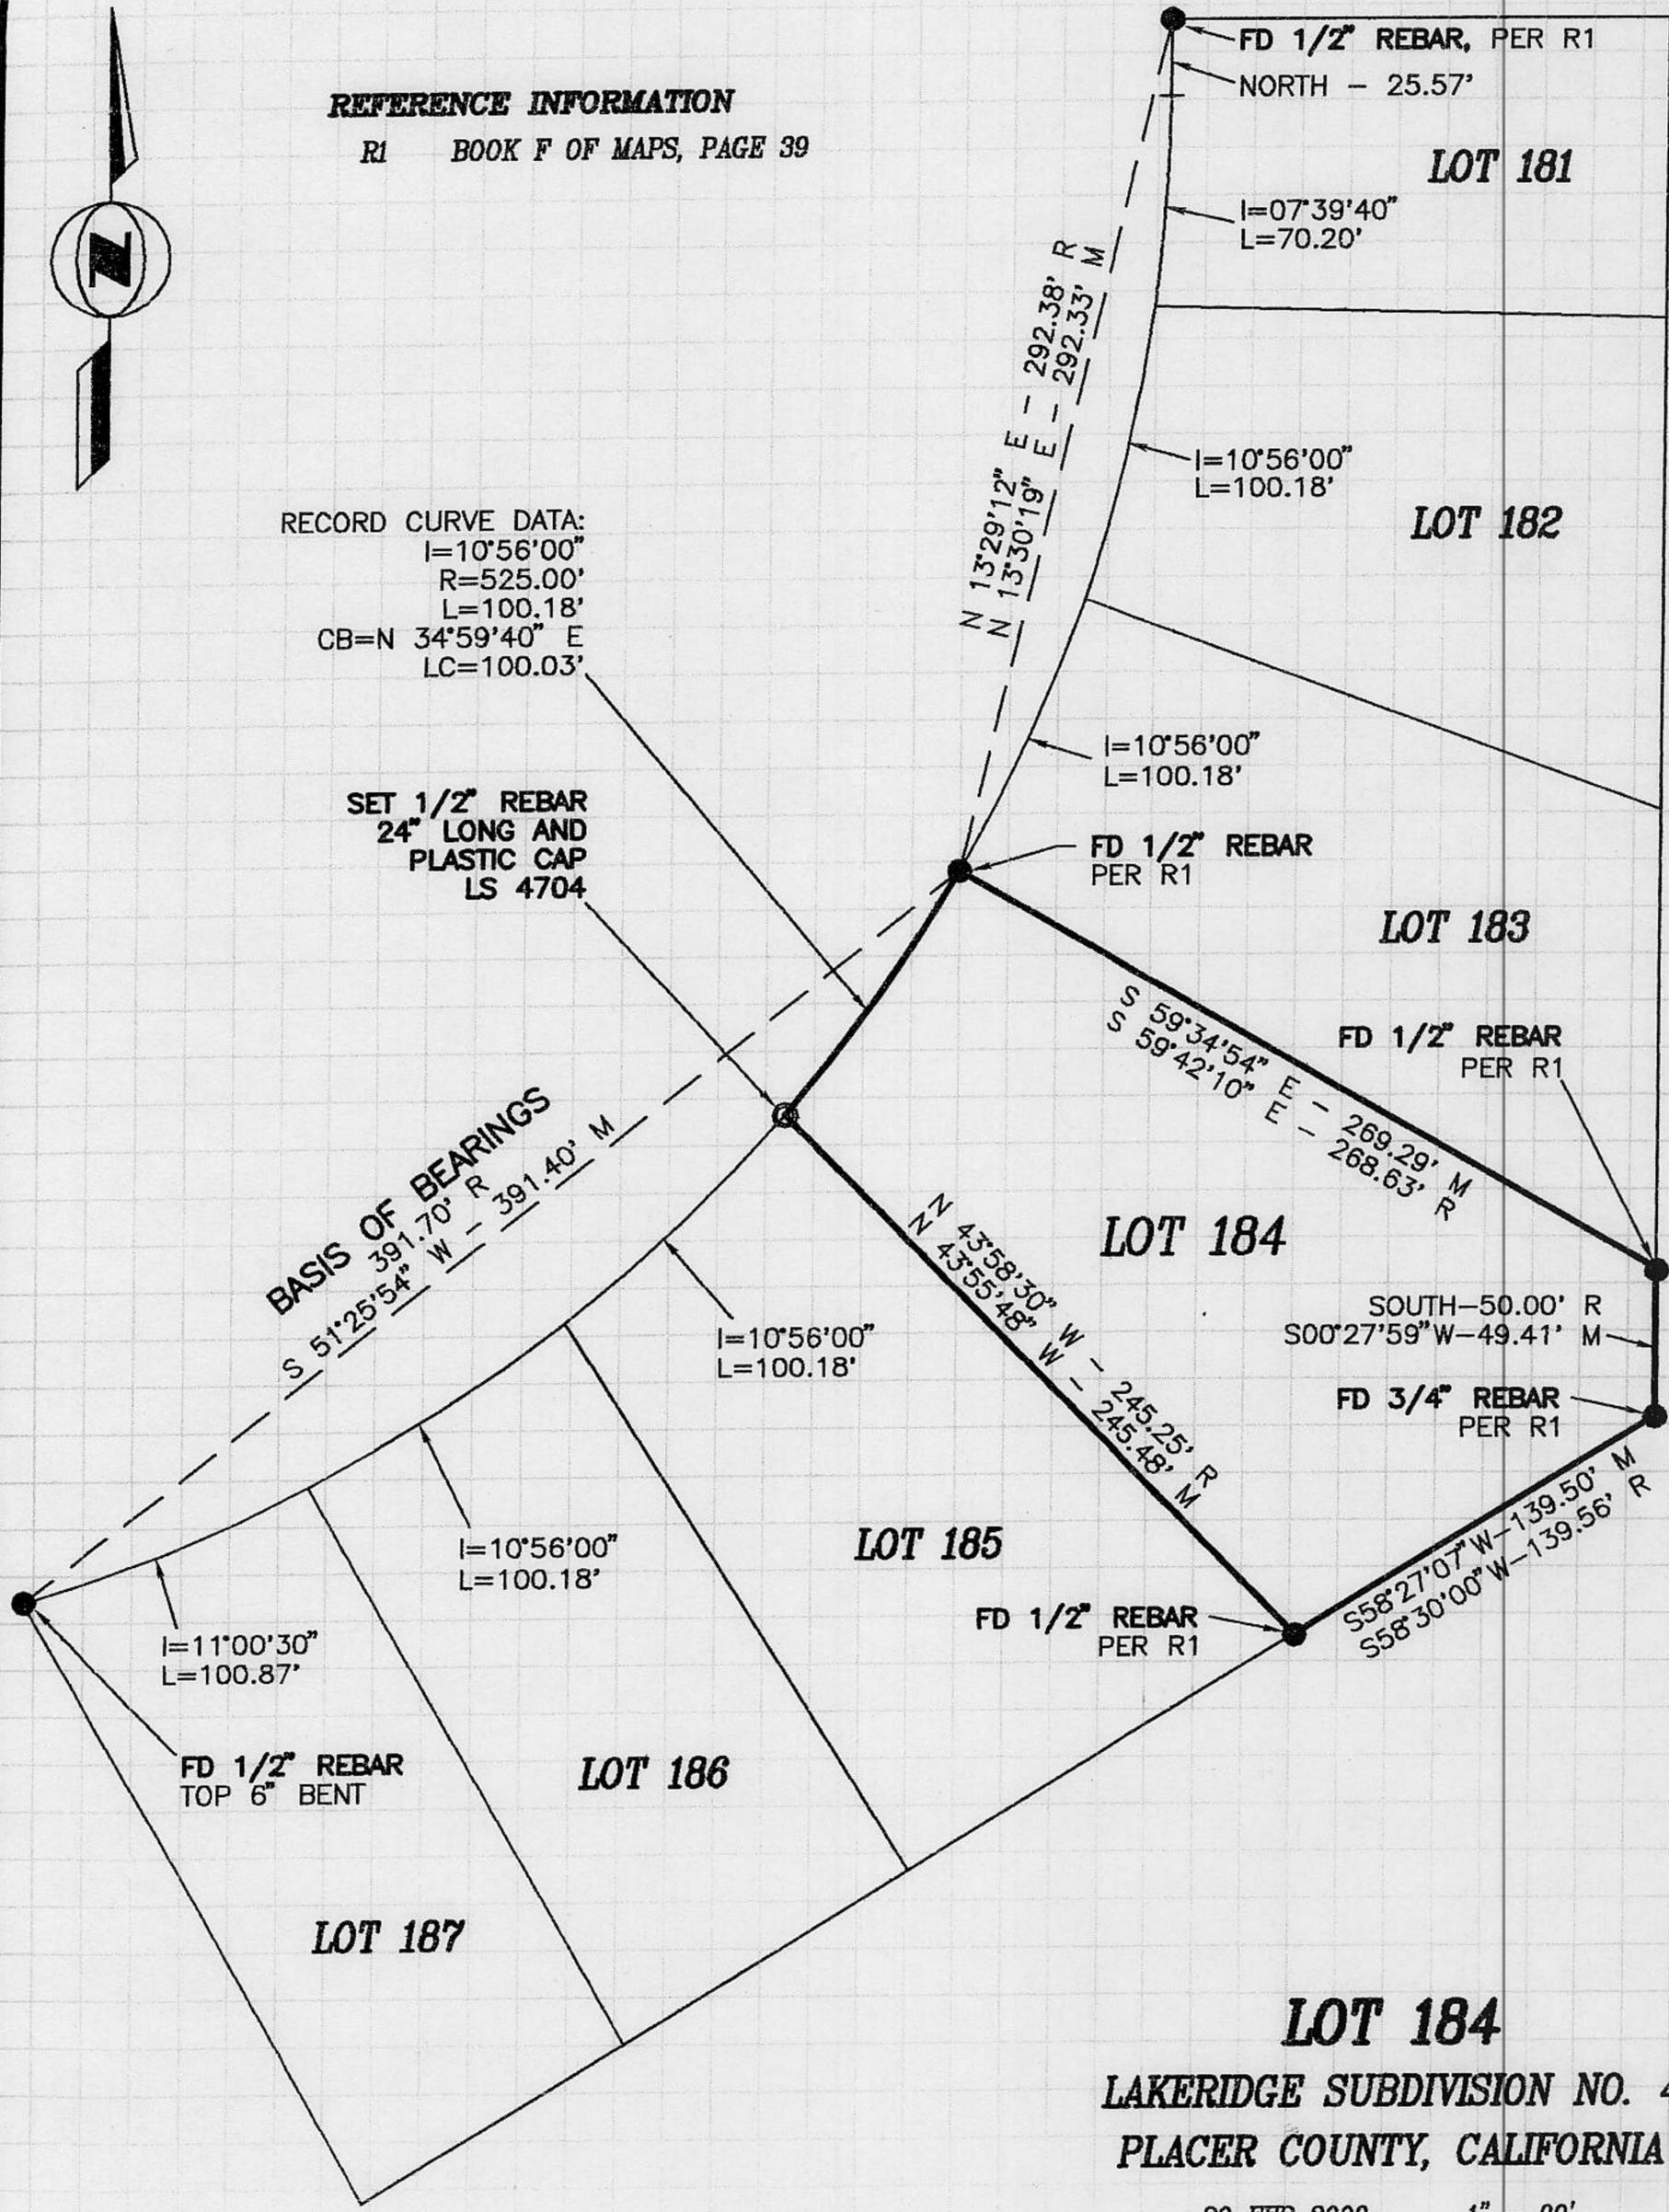

LOT 184
LAKERIDGE SUBDIVISION NO. 4
PLACER COUNTY, CALIFORNIA

29 FEB 2000 1" = 80'