


# CORNER RECORD

Agency Index BK 24 PG 25  
 Document Number 20210057

City of \_\_\_\_\_ County of Placer, California  
 Brief Legal Description RECORD SURVEY #2241, BOOK 16 OF SURVEYS, PAGE 75

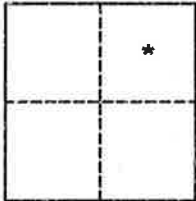

SEC 14  
T 10 N  
R 6 E

- CORNER TYPE**
- Government Corner     Control  
 Meander                     Property  
 Rancho                         Other

Date of Survey AUGUST 8, 2018

- COORDINATES (Optional)**
- N. \_\_\_\_\_ E. \_\_\_\_\_  
 Elevation \_\_\_\_\_  
 Units     Metric             U.S. Survey Foot  
 Horizontal Datum \_\_\_\_\_  
 Zone \_\_\_\_\_ Epoch Date \_\_\_\_\_  
 Vertical Datum \_\_\_\_\_  
 Complies with Public Resources Code §§8891-8819  
 Complies with Public Resources Code §§8890-8902

- PLS Act Ref.:     8765(d)             8771(c)             8773             Other:
- Corner/  
Monument:     Left as found             Established             Rebuilt             Pre-Construction  
 Found and tagged             Reestablished             Referenced             Post-Construction

Narrative of corner identified and monument as found, set, reset, replaced, or removed:  
 See sheet #2 for description(s):

FOUND 3/4" IRON PIPE WITH CAP "LS 3475" PER RECORD OF SURVEY #2241,  
 RECORDED IN BOOK 16 OF SURVEYS, PAGE 75, P.C.R. AS NOTED AND  
 DEPICTED ON PAGE 2.

FOUND (2) 3/4" IRON PIPES NO TAG USED AS REFERENCE POINTS  
 AS NOTED AND DEPICTED ON PAGE 2.

SET MAG NAIL REFERENCE POINT AS NOTED AND DEPICTED ON PAGE 2.

**SURVEYOR'S STATEMENT**

This Corner Record was prepared by me or under my direction in conformance with  
 the Professional Land Surveyors Act on AUGUST 5, 2021  
 Signed [Signature] P.L.S. or R.C.E. No. RCE33407




**COUNTY SURVEYOR'S STATEMENT**

This Corner Record was received OCTOBER 27, 2021  
 and examined and filed NOVEMBER 22, 2021  
 Signed [Signature] P.L.S. or R.C.E. No. 8373  
 Title Deputy Co. Surveyor  
 County Surveyor's Comment \_\_\_\_\_





BOOK 24 of CORNER RECORDS PAGE 25

10/20/21

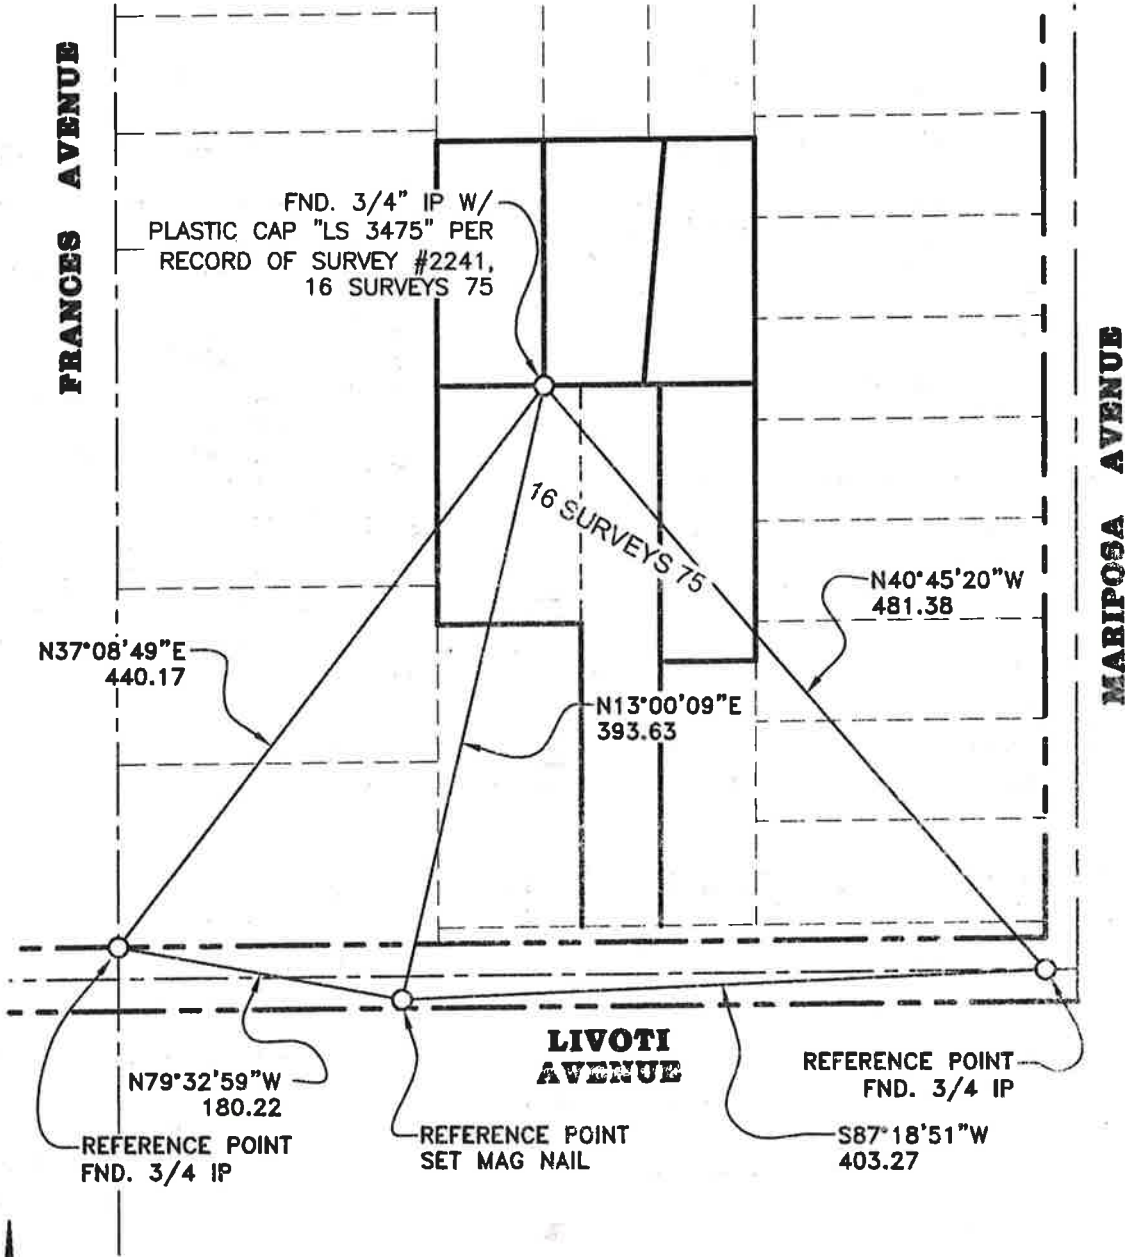

BOOK 24 of CORNER RECORDS PAGE 25

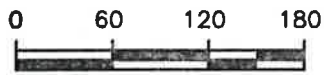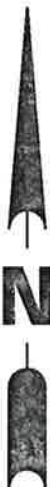

SCALE: 1" = 120'

LEGEND

- BOUNDARY LINE
- CENTERLINE (C)
- RIGHT OF WAY (R/W)
- FOUND AS NOTED

NOTE

FIELD SURVEY WAS PERFORMED FOR THIS EXHIBIT. ALL DIMENSIONS SHOWN ARE DETERMINED PER FIELD SURVEY COMPLETED ON AUGUST 8, 2018.