


ON-SITE SEWAGE DISPOSAL "AS-BUILT" PLOT PLAN

(To be provided to system installer for submittal to EHS at job completion)

Owners Name: _____ APN# _____

Job Location: _____ Scale: _____

Company Name & Address: _____

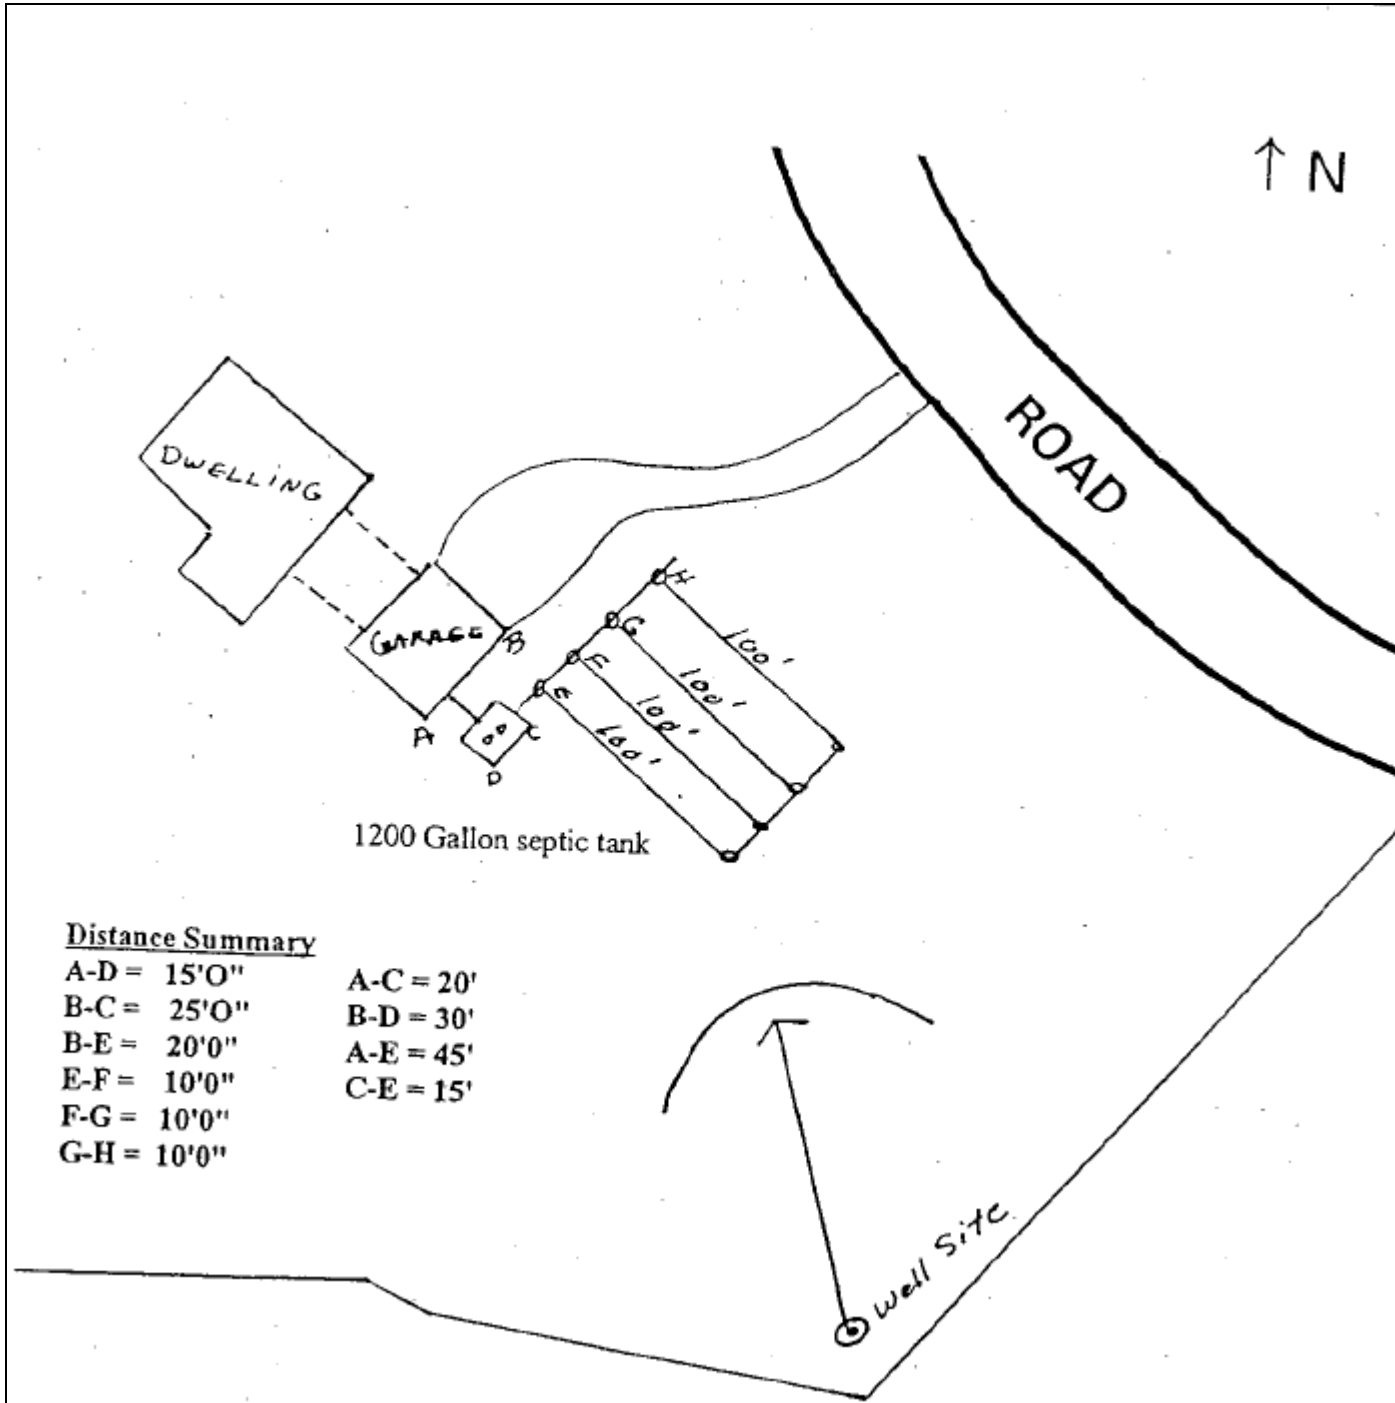

Date Completed: _____ Installer's Signature: _____

FOR DEPARTMENT USE

As-Built Approved: _____ By: _____ Permit # _____