


ON-SITE SEWAGE DISPOSAL "AS-BUILT" PLOT PLAN - EXAMPLE

(To be provided to system installer for submittal to Placer County Environmental Health at job completion)

Owner Name: _____ APN: _____
 Job Location: _____ Scale: _____
 Company Name/Address: _____

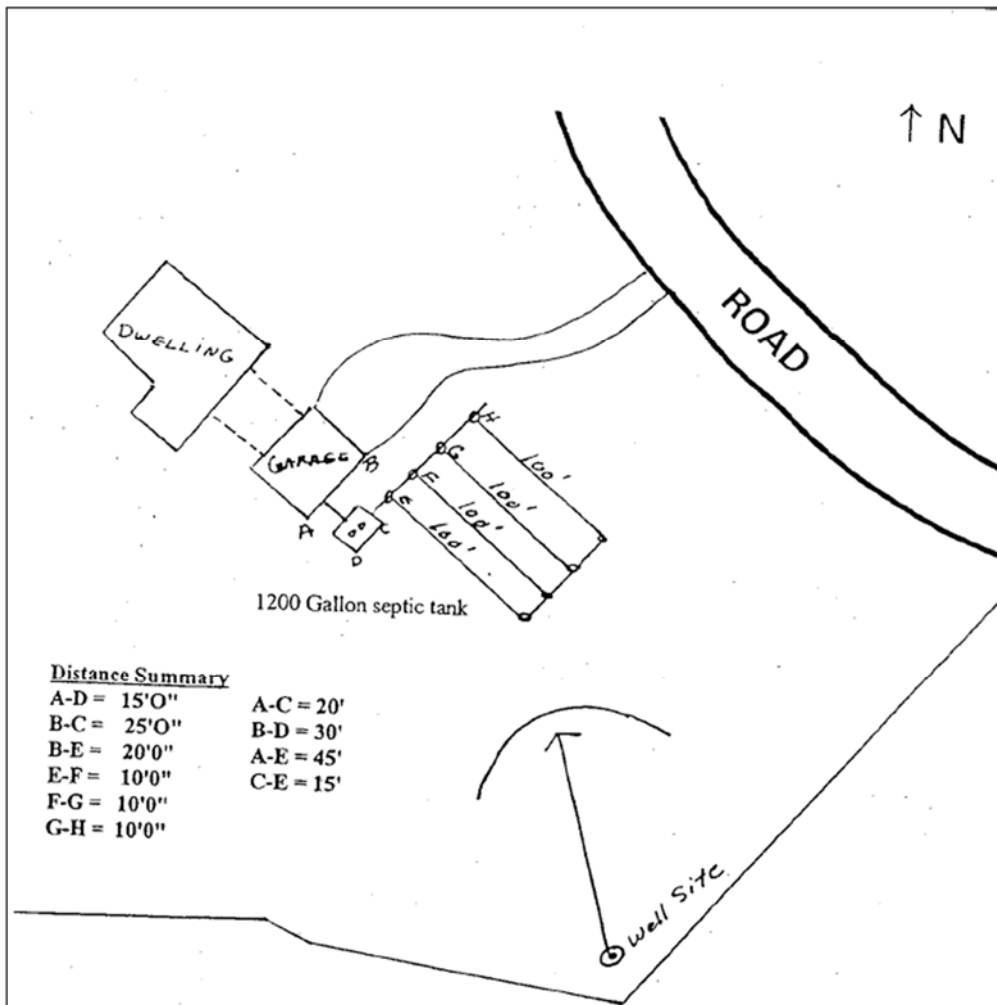

Installer Name Printed: _____

Installer Signature: _____ Date Completed: _____

<u>For Office Use Only</u>		
As-Built Approved: _____	By: _____	Permit#: _____