CORNER RECORD

Document Number _____

City of ~~XXXX~~ UNINCORPORATED AREA OF PLACER COUNTY County of _____, California

Brief Legal Description LOTS 8 & 9 FORESTHILL ESTATES UNIT 1--N/MAPS/16

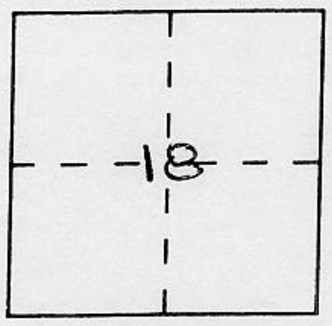

T13N
R10E

CORNER TYPE

Government Corner ☐ Control ☐
Meander ☐ Property ☐
Rancho ☐ Other ☐
Date of Survey _____

COORDINATES *(Optional)*

N. _____
E. _____
Zone _____ Datum _____
Elev. _____

Corner — Left as found ☐ Found and tagged ☐ Established ☐ Reestablished ☒ XX Rebuilt ☐

BOOK 1 CORNER RECORDS PAGE 5

Identification and type of corner found: Evidence used to identify or procedure used to establish or reestablish the corner:

SEE MAP

A description of the physical condition of the monument as found and as set or reset: SEE MAP

SURVEYOR'S STATEMENT

This Corner Record was prepared by me or under my direction in conformance with the Land Surveyors' Act on JUNE 27, ~~19XX~~ 2000

Signed Emerson L Smith L.S. or R.C.E. Number LS 3062
EX. 6/30/04

LICENSED LAND SURVEYOR
EMERSON L. SMITH
LS 3062
Ex
6/30/04
STATE OF CALIFORNIA

COUNTY SURVEYOR'S STATEMENT

This Corner Record was received _____ 19 ___ and examined and filed May 23 ~~19~~ 2001

Signed John Rietjens Title C. SURVEYOR

LICENSED LAND SURVEYOR
JOHN H. RIETJENS SEAL
6-30-2001
L.S. 4323
STATE OF CALIFORNIA

County Surveyor's Comment _____

PWA-102 (8/88)

BOOK 7 CORNER RECORDS PAGE 5

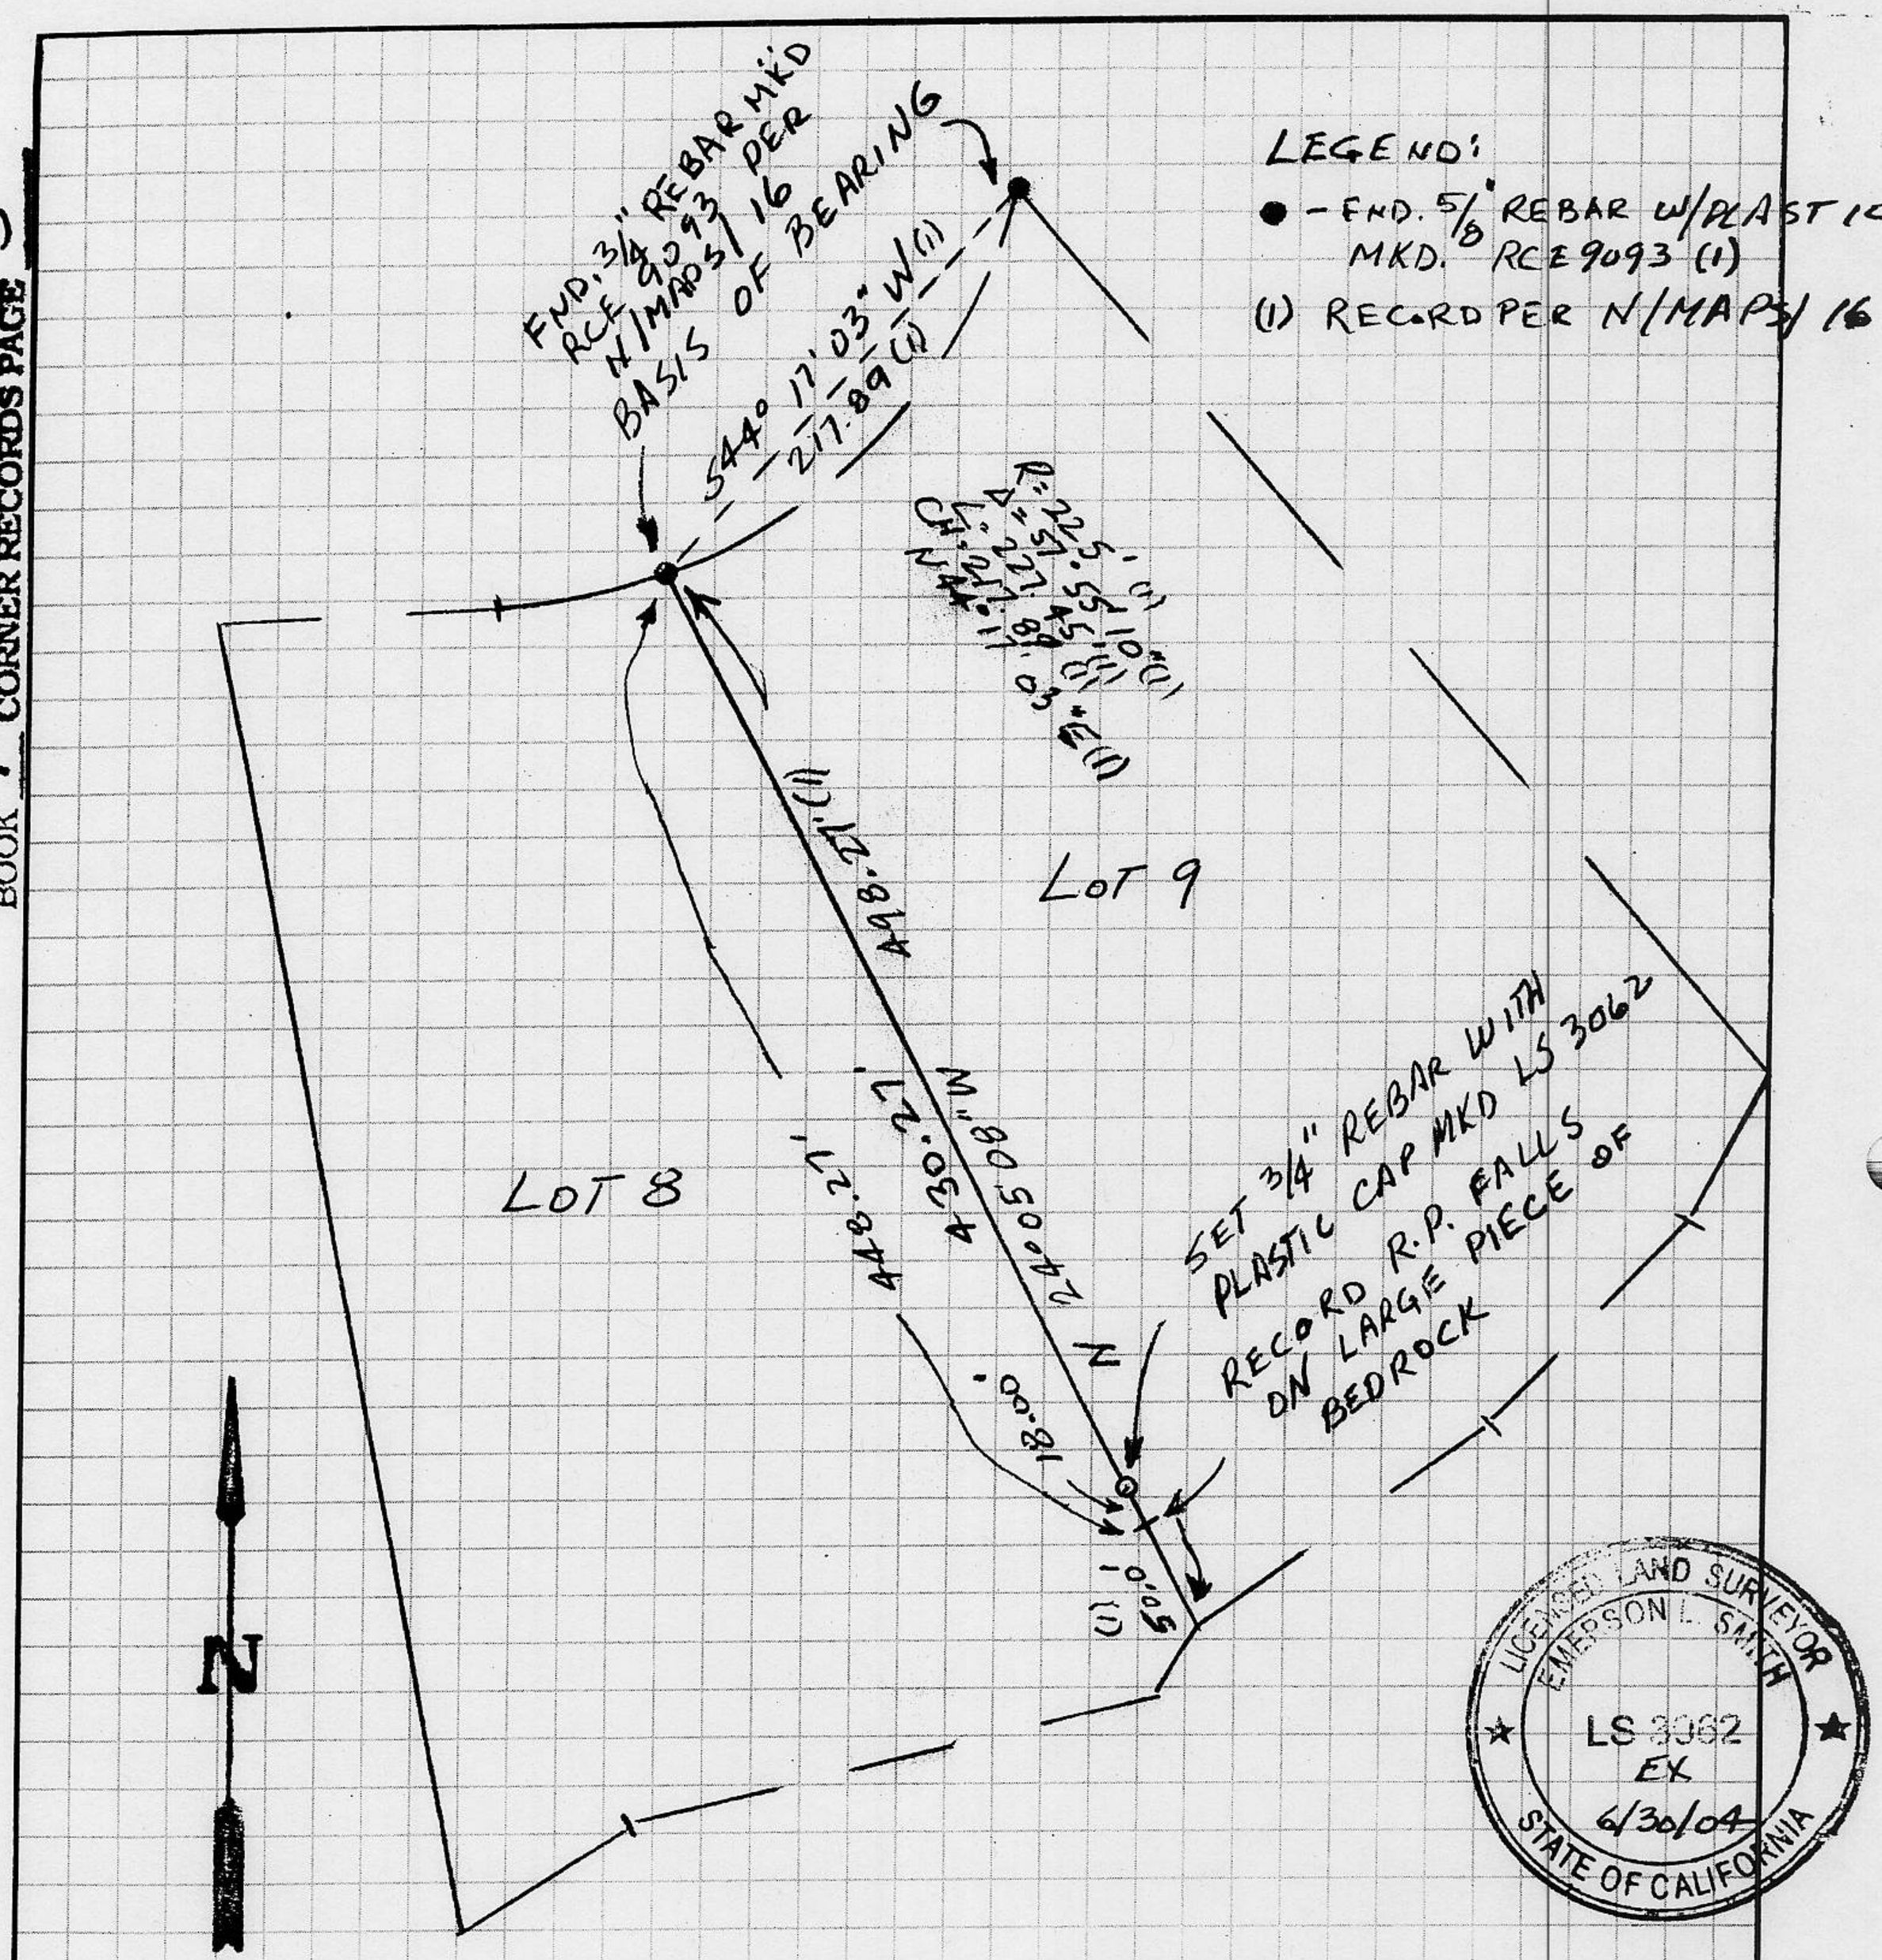

LEGEND:

● - FND. 5/8" REBAR W/PLASTIC CAP MKD. RCE 9093 (1)

(1) RECORD PER N/MAPS/16

LICENSED LAND SURVEYOR
EMERSON L. SMITH
LS 3062
EX
6/30/04
STATE OF CALIFORNIA

1"=100' MAP SHOWING LOTS 8 & 9 OF FORESTHILL ESTATES UNIT 1, N/MAPS/16 AND LINE SURVEYED FOR DALE FAGERNAS.

EMERSON L. SMITH - LS 3062