PLANT LEGEND

ABBR.	BOTANICAL NAME	COMMON NAME	QTY.	SIZE	COMMENTS
TREES					
Pe	Prunus emarginata	Bittercheery	8	2" Cal.	
Pt	Populus tremuloides	Aspen	52	2" - 3" Cal.	
Sc	Sorbus californica	Mountain Ash	22	2" Cal.	
SHRUBS					
Aa	Amelanchier alnifolia	Western Serviceberry	53	5 gal.	
Cs	Cpmus sericea	Redstem Dogwood	32	5 gal.	
Pf	Potentilla fruticosa	Shrubby cinquefoil	210	5 gal.	
Ra	Ribes nevadense	Mountain Currant	126	5 gal.	
Rw	Rosa woodsii	Woods Rose	13	5 gal.	
Sd	Spirea densoflora	Mountain Spirea	141	5 gal.	

ABBR.	BOTANICAL NAME	COMMON NAME	QTY.	SIZE	COMMENTS
Perennials					
Am	Achillea millefolium	Yarrow	67	1 gal.	
As	Aster alpinus	Alpine Aster	394	1 gal.	
Fv	Fragaria virginiana	Mountain Strawberry	1030	1 gal.	
Go	Galium odoratum	Sweet Woodruff	294	1 gal.	
Lp	Lupinus polyphyllus	Large Leaved Lupine	830	1 gal.	
Ls	Leucanthemum x superbum	Shasta Daisy	885	1 gal.	
Ph	Penstemon newberryi	Penstemon, Mountain Pride	323	1 gal.	
Rp	Rubus parviflorus	Thimbleberry	440	1 gal.	

REVISION #	DATE:	DESCRIPTION AND SHEET NO.:	APPROVED BY:	DATE:

stamp

THE COUNTY OF PLACER OR ITS OFFICERS OR AGENTS SHALL NOT BE RESPONSIBLE FOR THE ACCURACY OR COMPLETENESS OF ELECTRONIC COPIES OF THIS PLAN SHEET.

RECORD DRAWINGS

NORTH

0 100' 200' 400'
1"=200'

FOR REDUCED PLANS ORIGINAL SCALE IS IN INCHES

0 1 2 3

ALL DIMENSIONS SHOWN IN FEET UNLESS OTHERWISE NOTED

PHASE 3

INITIALS DATE

PLAN SCALE:
PROFILE SCALE:
HORIZ:
VERT:

DATE:
DESIGNED:
DRAWN:
CHECKED:
RECORD DRAWING:

CONTRACT NO. 1095

DESIGNWORKSHOP
LANDSCAPE ARCHITECTURE
PO Box 5666, 128 Market Street, Suite 3E
Stateline, Nevada 89449-5666
(775) 588-5929
WWW.DESIGNWORKSHOP.COM

COUNTY OF PLACER DEPARTMENT OF PUBLIC WORKS
KINGS BEACH COMMERCIAL CORE IMPROVEMENT PROJECT PHASE 3

LANDSCAPE MATERIALS PLANS

SHEET NO.
L1-0
OF

PLANT LEGEND

ABBR.	BOTANICAL NAME	COMMON NAME	QTY.	SIZE	COMMENTS
TREES					
Pe	Prunus emarginata	Bittercheery	0	2" Cal.	
Pt	Populus tremuloides	Aspen	0	2" - 3" Cal.	
Sc	Sorbus californica	Mountain Ash	0	2" Cal.	
SHRUBS					
Aa	Amelanchier alnifolia	Western Serviceberry	0	5 gal.	
Cs	Cprnus sericea	Redstem Dogwood	0	5 gal.	
Pf	Potentilla fruticosa	Shrubby cinquefoil	0	5 gal.	
Ra	Ribes nevadense	Mountain Currant	0	5 gal.	
Rw	Rosa woodsii	Woods Rose	0	5 gal.	
Sd	Spirea densoflora	Mountain Spirea	0	5 gal.	

ABBR.	BOTANICAL NAME	COMMON NAME	QTY.	SIZE	COMMENTS
Perennials					
Am	Achillea millefolium	Yarrow	0	1 gal.	
As	Aster alpinus	Alpine Aster	0	1 gal.	
Fv	Fragaria virginiana	Mountain Strawberry	0	1 gal.	
Go	Galium odoratum	Sweet Woodruff	0	1 gal.	
Lp	Lupinus polyphyllus	Large Leaved Lupine	0	1 gal.	
Ls	Leucanthemum x superbum	Shasta Daisy	0	1 gal.	
Ph	Penstemon newberryi	Penstemon, Mountain Pride	0	1 gal.	
Rp	Rubus parviflorus	Thimbleberry	0	1 gal.	

REVISION #	DATE:	DESCRIPTION AND SHEET NO.:	APPROVED BY:	DATE:

stamp

THE COUNTY OF PLACER OR ITS OFFICERS OR AGENTS SHALL NOT BE RESPONSIBLE FOR THE ACCURACY OR COMPLETENESS OF ELECTRONIC COPIES OF THIS PLAN SHEET.

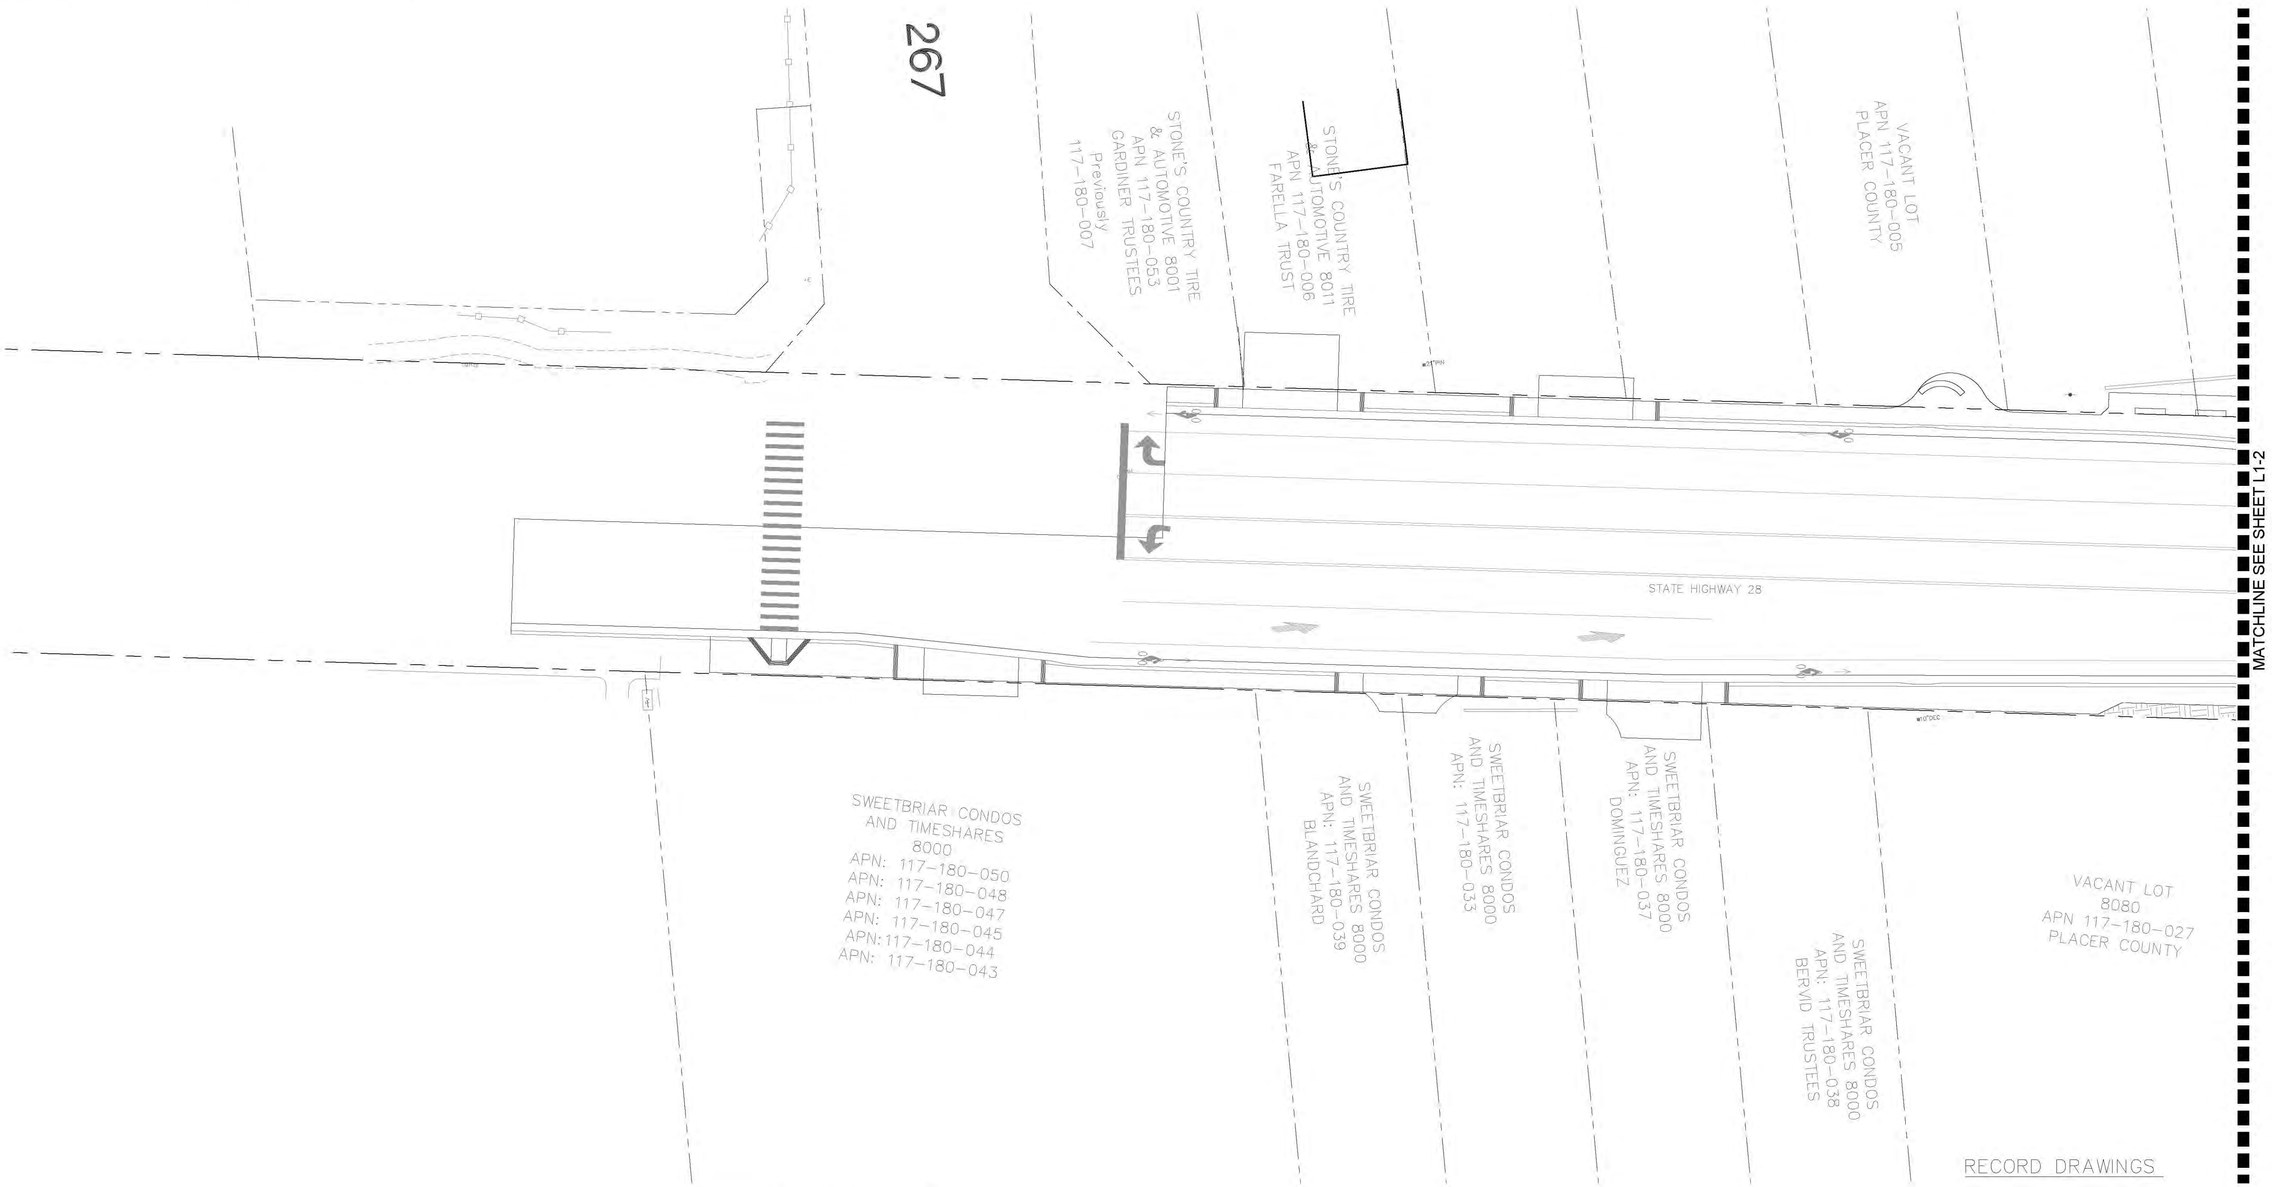

FOR REDUCED PLANS ORIGINAL SCALE IS IN INCHES

ALL DIMENSIONS SHOWN IN FEET UNLESS OTHERWISE NOTED

PHASE 3

INITIALS DATE

PLAN SCALE: PROFILE SCALE: HORIZ: VERT:

DATE: DESIGNED: DRAWN: CHECKED: RECORD DRAWING:

CONTRACT NO. 1095

DESIGNWORKSHOP
LANDSCAPE ARCHITECTURE
PO Box 5666 - 128 Market Street, Suite 3E
Stateline, Nevada 89449-5666
(775) 588-5929
WWW.DESIGNWORKSHOP.COM

COUNTY OF PLACER DEPARTMENT OF PUBLIC WORKS
KINGS BEACH COMMERCIAL CORE IMPROVEMENT PROJECT PHASE 3

LANDSCAPE MATERIALS PLANS

SHEET NO. L1-1 OF

PLANT LEGEND

ABBR.	BOTANICAL NAME	COMMON NAME	QTY.	SIZE	COMMENTS
TREES					
Pe	Prunus emarginata	Bittercheery	0	2" Cal.	
Pt	Populus tremuloides	Aspen	9	2" - 3" Cal.	
Sc	Sorbus californica	Mountain Ash	4	2" Cal.	
SHRUBS					
Aa	Amelanchier alnifolia	Western Serviceberry	3	5 gal.	
Cs	Cprnus sericea	Redstem Dogwood	2	5 gal.	
Pf	Potentilla fruticosa	Shrubby cinquefoil	3	5 gal.	
Ra	Ribes nevadense	Mountain Currant	10	5 gal.	
Rw	Rosa woodsii	Woods Rose	0	5 gal.	
Sd	Spirea densoflora	Mountain Spirea	0	5 gal.	

ABBR.	BOTANICAL NAME	COMMON NAME	QTY.	SIZE	COMMENTS
Perennials					
Am	Achillea millefolium	Yarrow	0	1 gal.	
As	Aster alpinus	Alpine Aster	0	1 gal.	
Fv	Fragaria virginiana	Mountain Strawberry	33	1 gal.	
Go	Galium odoratum	Sweet Woodruff	0	1 gal.	
Lp	Lupinus polyphyllus	Large Leaved Lupine	0	1 gal.	
Ls	Leucanthemum x superbum	Shasta Daisy	20	1 gal.	
Ph	Penstemon newberryi	Penstemon, Mountain Pride	14	1 gal.	
Rp	Rubus parviflorus	Thimbleberry	0	1 gal.	

REVISION #	DATE:	DESCRIPTION AND SHEET NO.:	APPROVED BY:	DATE:

stamp

THE COUNTY OF PLACER OR ITS OFFICERS OR AGENTS SHALL NOT BE RESPONSIBLE FOR THE ACCURACY OR COMPLETENESS OF ELECTRONIC COPIES OF THIS PLAN SHEET.

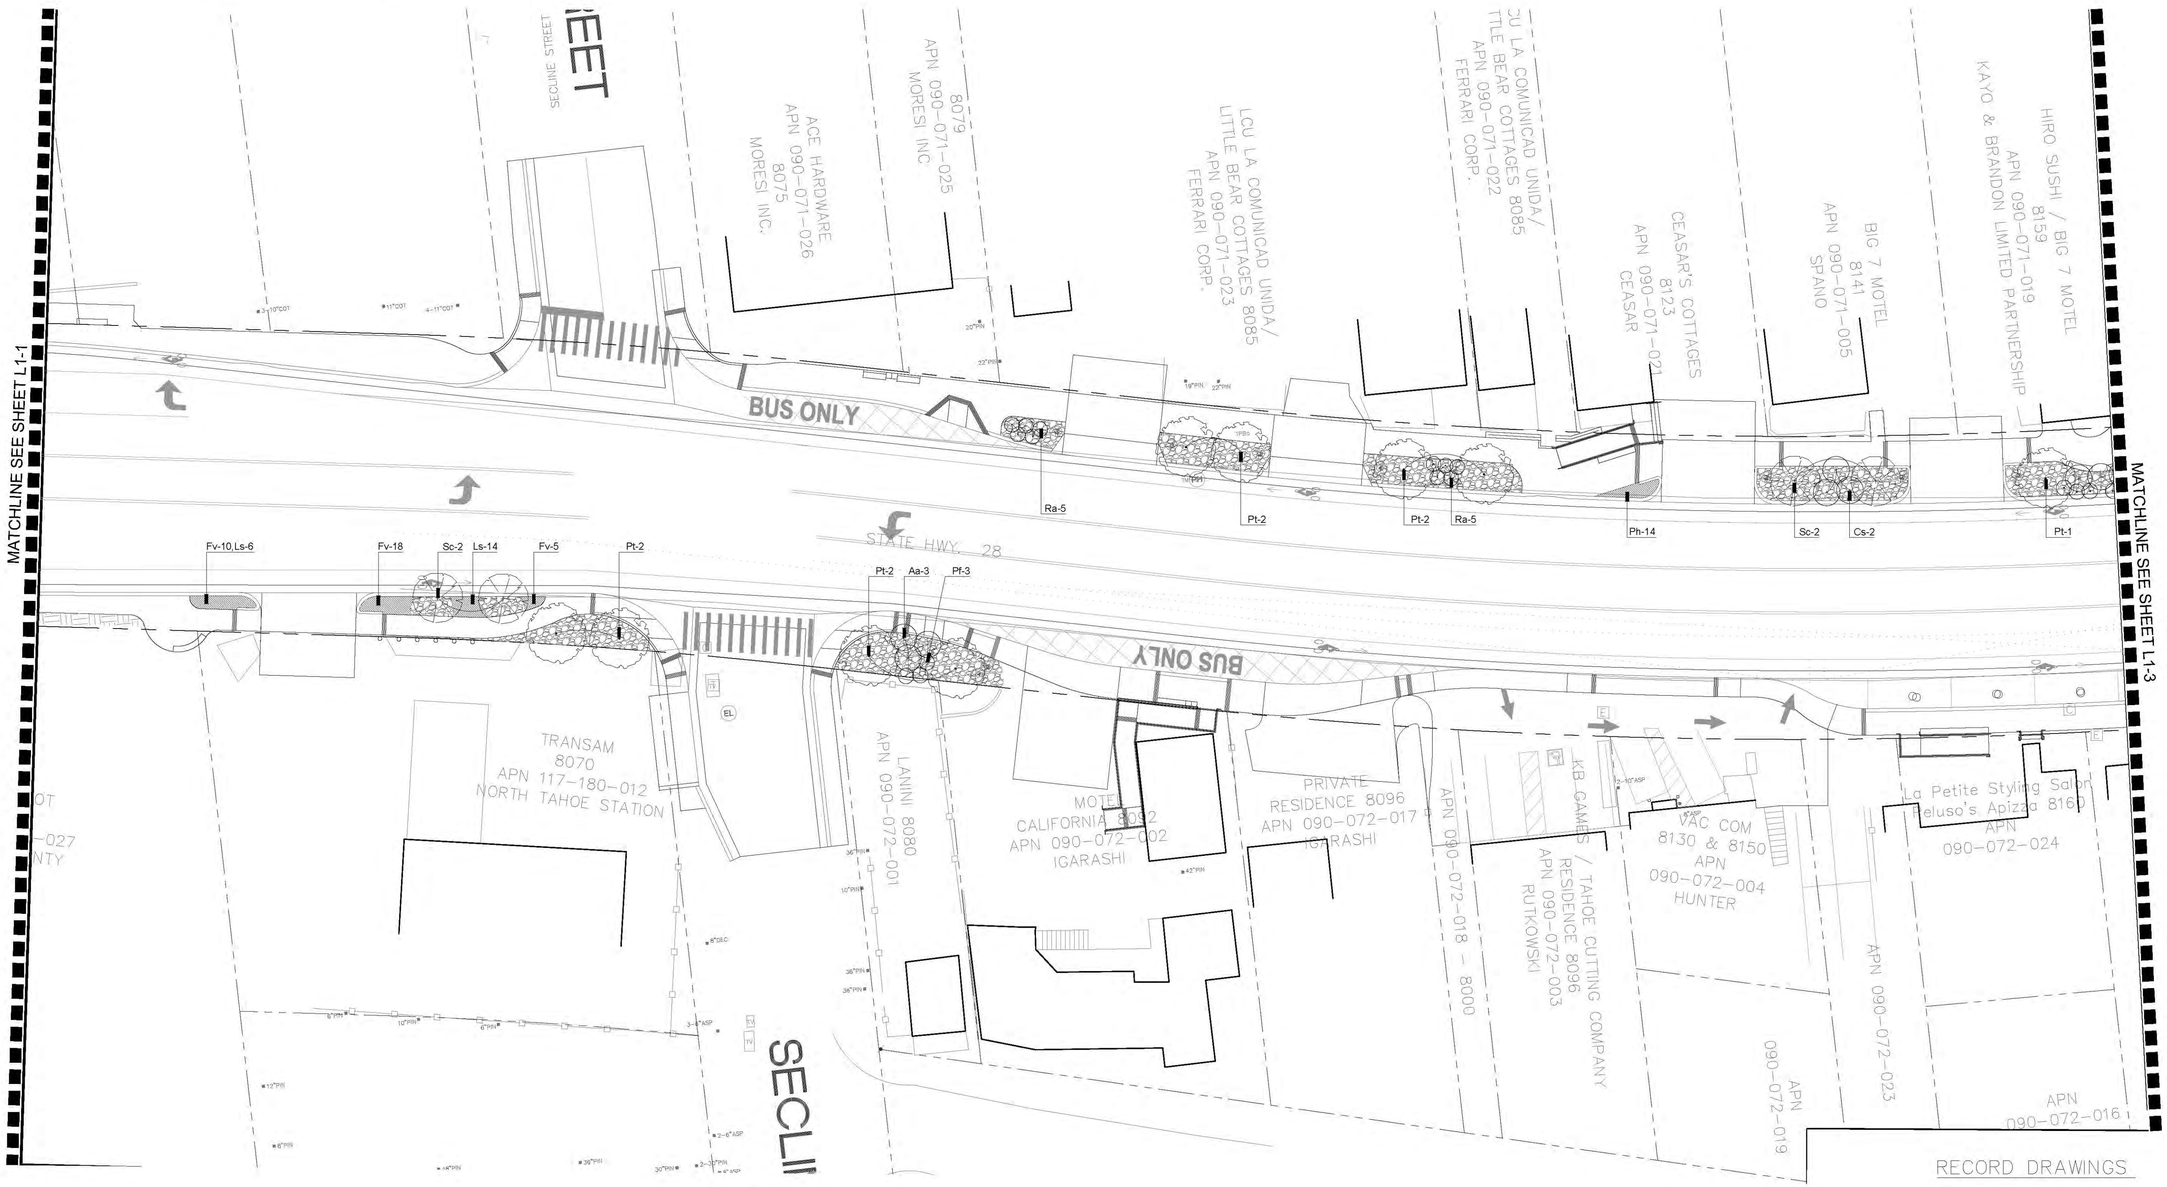

RECORD DRAWINGS

NORTH

0 10' 20' 40'
1"=20'

FOR REDUCED PLANS
ORIGINAL SCALE IS IN INCHES

0 1 2 3

ALL DIMENSIONS SHOWN IN FEET
UNLESS OTHERWISE NOTED

PHASE 3

INITIALS DATE

PLAN SCALE:
PROFILE SCALE:
HORIZ:
VERT:

DATE:
DESIGNED:
DRAWN:
CHECKED:
RECORD DRAWING:

CONTRACT NO. 1095

DESIGNWORKSHOP
LANDSCAPE ARCHITECTURE
PO Box 5666, 128 Market Street, Suite 3E
Stateline, Nevada 89449-5666
(775) 588-5929
WWW.DESIGNWORKSHOP.COM

COUNTY OF PLACER DEPARTMENT OF PUBLIC WORKS
KINGS BEACH COMMERCIAL CORE IMPROVEMENT PROJECT PHASE 3

LANDSCAPE MATERIALS PLANS

SHEET NO.
L1-2
OF

PLANT LEGEND

ABBR.	BOTANICAL NAME	COMMON NAME	QTY.	SIZE	COMMENTS
TREES					
Pe	Prunus emarginata	Bittercheery	1	2" Cal.	
Pt	Populus tremuloides	Aspen	9	2" - 3" Cal.	
Sc	Sorbus californica	Mountain Ash	3	2" Cal.	
SHRUBS					
Aa	Amelanchier alnifolia	Western Serviceberry	10	5 gal.	
Cs	Cprnus sericea	Redstem Dogwood	5	5 gal.	
Pf	Potentilla fruticosa	Shrubby cinquefoil	23	5 gal.	
Ra	Ribes nevadense	Mountain Currant	13	5 gal.	
Rw	Rosa woodsii	Woods Rose	2	5 gal.	
Sd	Spirea densoflora	Mountain Spirea	26	5 gal.	

ABBR.	BOTANICAL NAME	COMMON NAME	QTY.	SIZE	COMMENTS
Perennials					
Am	Achillea millefolium	Yarrow	22	1 gal.	
As	Aster alpinus	Alpine Aster	0	1 gal.	
Fv	Fragaria virginiana	Mountain Strawberry	45	1 gal.	
Go	Galium odoratum	Sweet Woodruff	72	1 gal.	
Lp	Lupinus polyphyllus	Large Leaved Lupine	30	1 gal.	
Ls	Leucanthemum x superbum	Shasta Daisy	30	1 gal.	
Ph	Penstemon newberryi	Penstemon, Mountain Pride	0	1 gal.	
Rp	Rubus parviflorus	Thimbleberry	52	1 gal.	

REVISION #	DATE:	DESCRIPTION AND SHEET NO.:	APPROVED BY:	DATE:

stamp

THE COUNTY OF PLACER OR ITS OFFICERS OR AGENTS SHALL NOT BE RESPONSIBLE FOR THE ACCURACY OR COMPLETENESS OF ELECTRONIC COPIES OF THIS PLAN SHEET.

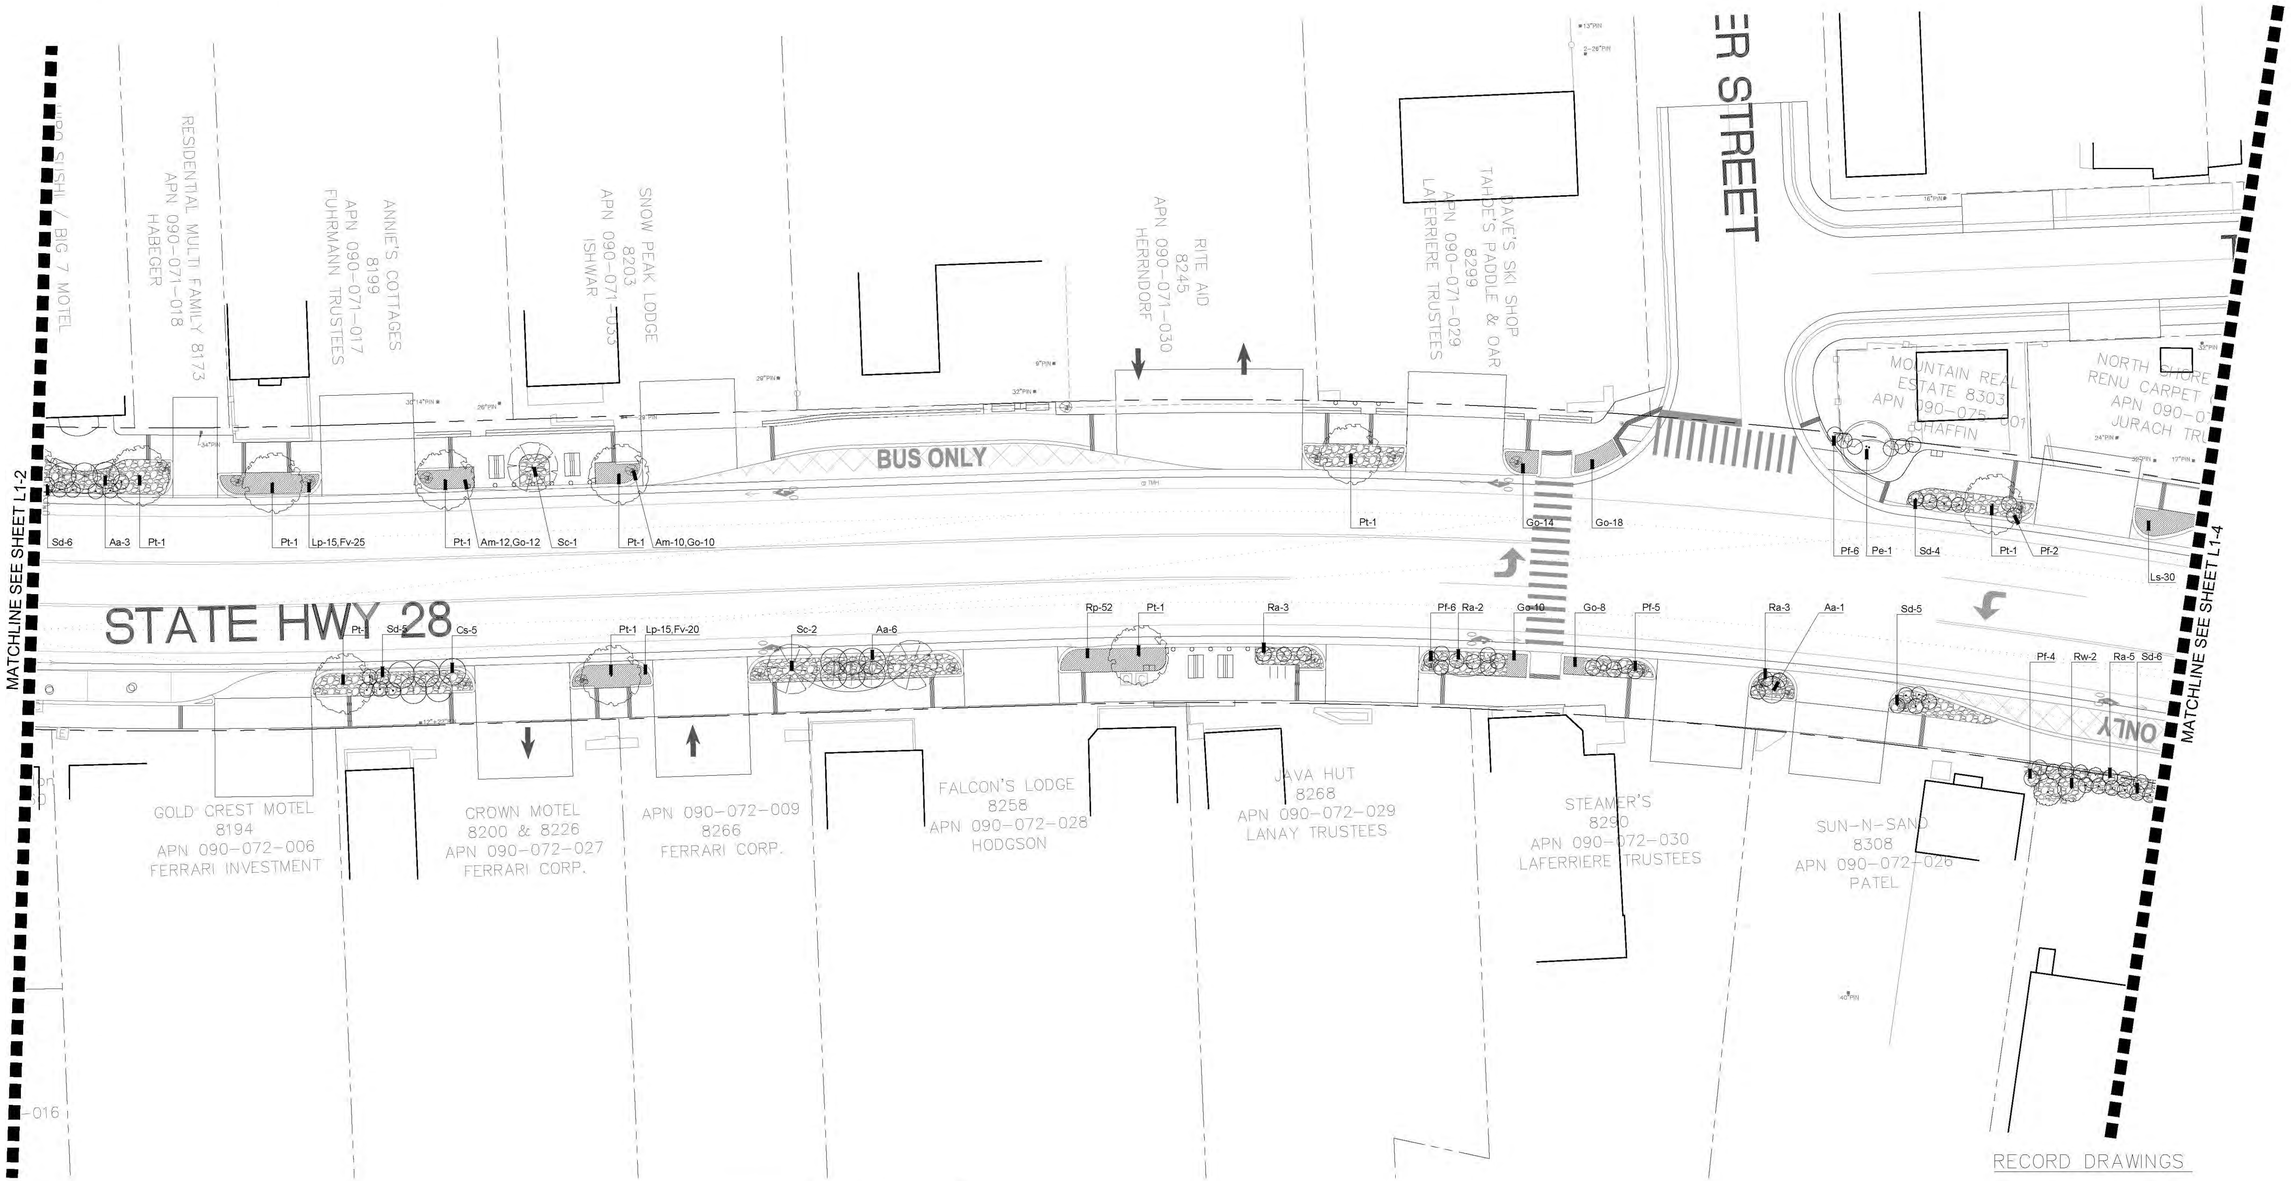

NORTH

0 10' 20' 40'
1"=20'

FOR REDUCED PLANS ORIGINAL SCALE IS IN INCHES

0 1 2 3

ALL DIMENSIONS SHOWN IN FEET UNLESS OTHERWISE NOTED

PHASE 3

INITIALS DATE

PLAN SCALE:
PROFILE SCALE:
HORIZ:
VERT:

DATE:
DESIGNED:
DRAWN:
CHECKED:
RECORD DRAWING:

CONTRACT NO. 1095

DESIGNWORKSHOP
LANDSCAPE ARCHITECTURE
PO Box 5666, 128 Market Street, Suite 3E
Stateline, Nevada 89449-5666
(775) 588-5929
WWW.DESIGNWORKSHOP.COM

COUNTY OF PLACER DEPARTMENT OF PUBLIC WORKS
KINGS BEACH COMMERCIAL CORE IMPROVEMENT PROJECT PHASE 3

LANDSCAPE MATERIALS PLANS

SHEET NO.
L1-3
OF

PLANT LEGEND

ABBR.	BOTANICAL NAME	COMMON NAME	QTY.	SIZE	COMMENTS
TREES					
Pe	Prunus emarginata	Bittercheery	0	2" Cal.	
Pt	Populus tremuloides	Aspen	0	2" - 3" Cal.	
Sc	Sorbus californica	Mountain Ash	0	2" Cal.	
SHRUBS					
Aa	Amelanchier alnifolia	Western Serviceberry	0	5 gal.	
Cs	Cprnus sericea	Redstem Dogwood	8	5 gal.	
Pf	Potentilla fruticosa	Shrubby cinquefoil	25	5 gal.	
Ra	Ribes nevadense	Mountain Currant	15	5 gal.	
Rw	Rosa woodsii	Woods Rose	5	5 gal.	
Sd	Spirea densoflora	Mountain Spirea	13	5 gal.	

ABBR.	BOTANICAL NAME	COMMON NAME	QTY.	SIZE	COMMENTS
Perennials					
Am	Achillea millefolium	Yarrow	0	1 gal.	
As	Aster alpinus	Alpine Aster	60	1 gal.	
Fv	Fragaria virginiana	Mountain Strawberry	0	1 gal.	
Go	Galium odoratum	Sweet Woodruff	60	1 gal.	
Lp	Lupinus polyphyllus	Large Leaved Lupine	0	1 gal.	
Ls	Leucanthemum x superbum	Shasta Daisy	60	1 gal.	
Ph	Penstemon newberryi	Penstemon, Mountain Pride	24	1 gal.	
Rp	Rubus parviflorus	Thimbleberry	0	1 gal.	

REVISION #	DATE:	DESCRIPTION AND SHEET NO.:	APPROVED BY:	DATE:

stamp

THE COUNTY OF PLACER OR ITS OFFICERS OR AGENTS SHALL NOT BE RESPONSIBLE FOR THE ACCURACY OR COMPLETENESS OF ELECTRONIC COPIES OF THIS PLAN SHEET.

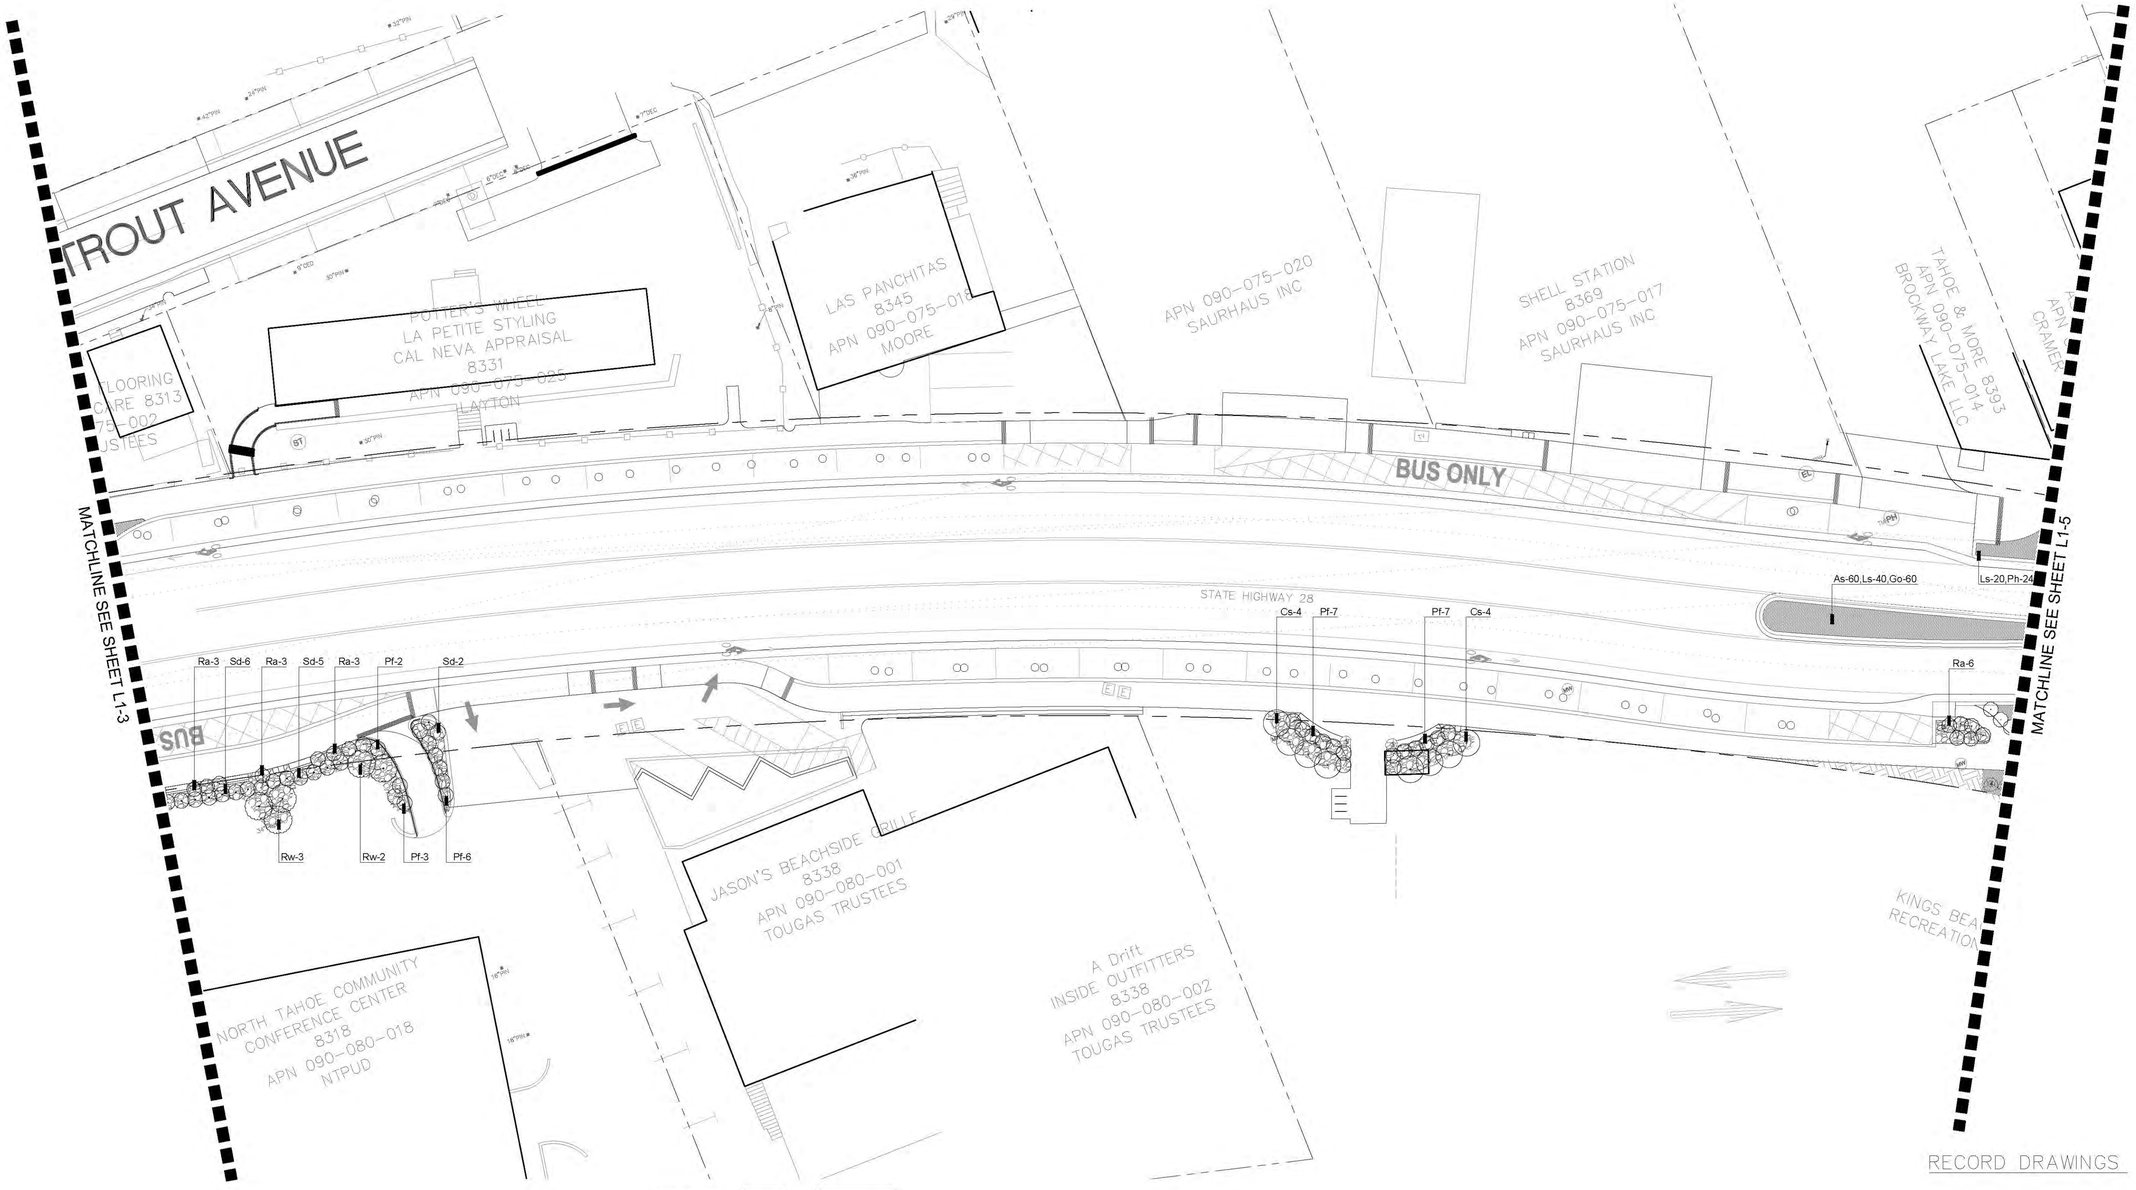

NORTH

0 10' 20' 40'
1"=20'

FOR REDUCED PLANS
ORIGINAL SCALE IS IN INCHES

0 1 2 3

ALL DIMENSIONS SHOWN IN FEET
UNLESS OTHERWISE NOTED

PHASE 3

INITIALS DATE

PLAN SCALE:
PROFILE SCALE:
HORIZ:
VERT:

DATE:
DESIGNED:
DRAWN:
CHECKED:
RECORD DRAWING:

CONTRACT NO. 1095

DESIGNWORKSHOP
LANDSCAPE ARCHITECTURE
PO Box 5666, 128 Market Street, Suite 3E
Stateline, Nevada 89449-5666
(775) 588-5929
WWW.DESIGNWORKSHOP.COM

COUNTY OF PLACER DEPARTMENT OF PUBLIC WORKS
KINGS BEACH COMMERCIAL CORE IMPROVEMENT PROJECT PHASE 3

LANDSCAPE MATERIALS PLANS

SHEET NO.
L1-4
OF

PLANT LEGEND

ABBR.	BOTANICAL NAME	COMMON NAME	QTY.	SIZE	COMMENTS
TREES					
Pe	Prunus emarginata	Bittercheery	4	2" Cal.	
Pt	Populus tremuloides	Aspen	4	2" - 3" Cal.	
Sc	Sorbus californica	Mountain Ash	0	2" Cal.	
SHRUBS					
Aa	Amelanchier alnifolia	Western Serviceberry	13	5 gal.	
Cs	Cprnus sericea	Redstem Dogwood	0	5 gal.	
Pf	Potentilla fruticosa	Shrubby cinquefoil	38	5 gal.	
Ra	Ribes nevadense	Mountain Currant	27	5 gal.	
Rw	Rosa woodsii	Woods Rose	2	5 gal.	
Sd	Spirea densoflora	Mountain Spirea	29	5 gal.	

ABBR.	BOTANICAL NAME	COMMON NAME	QTY.	SIZE	COMMENTS
Perennials					
Am	Achillea millefolium	Yarrow	5	1 gal.	
As	Aster alpinus	Alpine Aster	100	1 gal.	
Fv	Fragaria virginiana	Mountain Strawberry	447	1 gal.	
Go	Galium odoratum	Sweet Woodruff	115	1 gal.	
Lp	Lupinus polyphyllus	Large Leaved Lupine	285	1 gal.	
Ls	Leucanthemum x superbum	Shasta Daisy	385	1 gal.	
Ph	Penstemon newberryi	Penstemon, Mountain Pride	197	1 gal.	
Rp	Rubus parviflorus	Thimbleberry	49	1 gal.	

REVISION #	DATE:	DESCRIPTION AND SHEET NO.:	APPROVED BY:	DATE:

stamp

THE COUNTY OF PLACER OR ITS OFFICERS OR AGENTS SHALL NOT BE RESPONSIBLE FOR THE ACCURACY OR COMPLETENESS OF ELECTRONIC COPIES OF THIS PLAN SHEET.

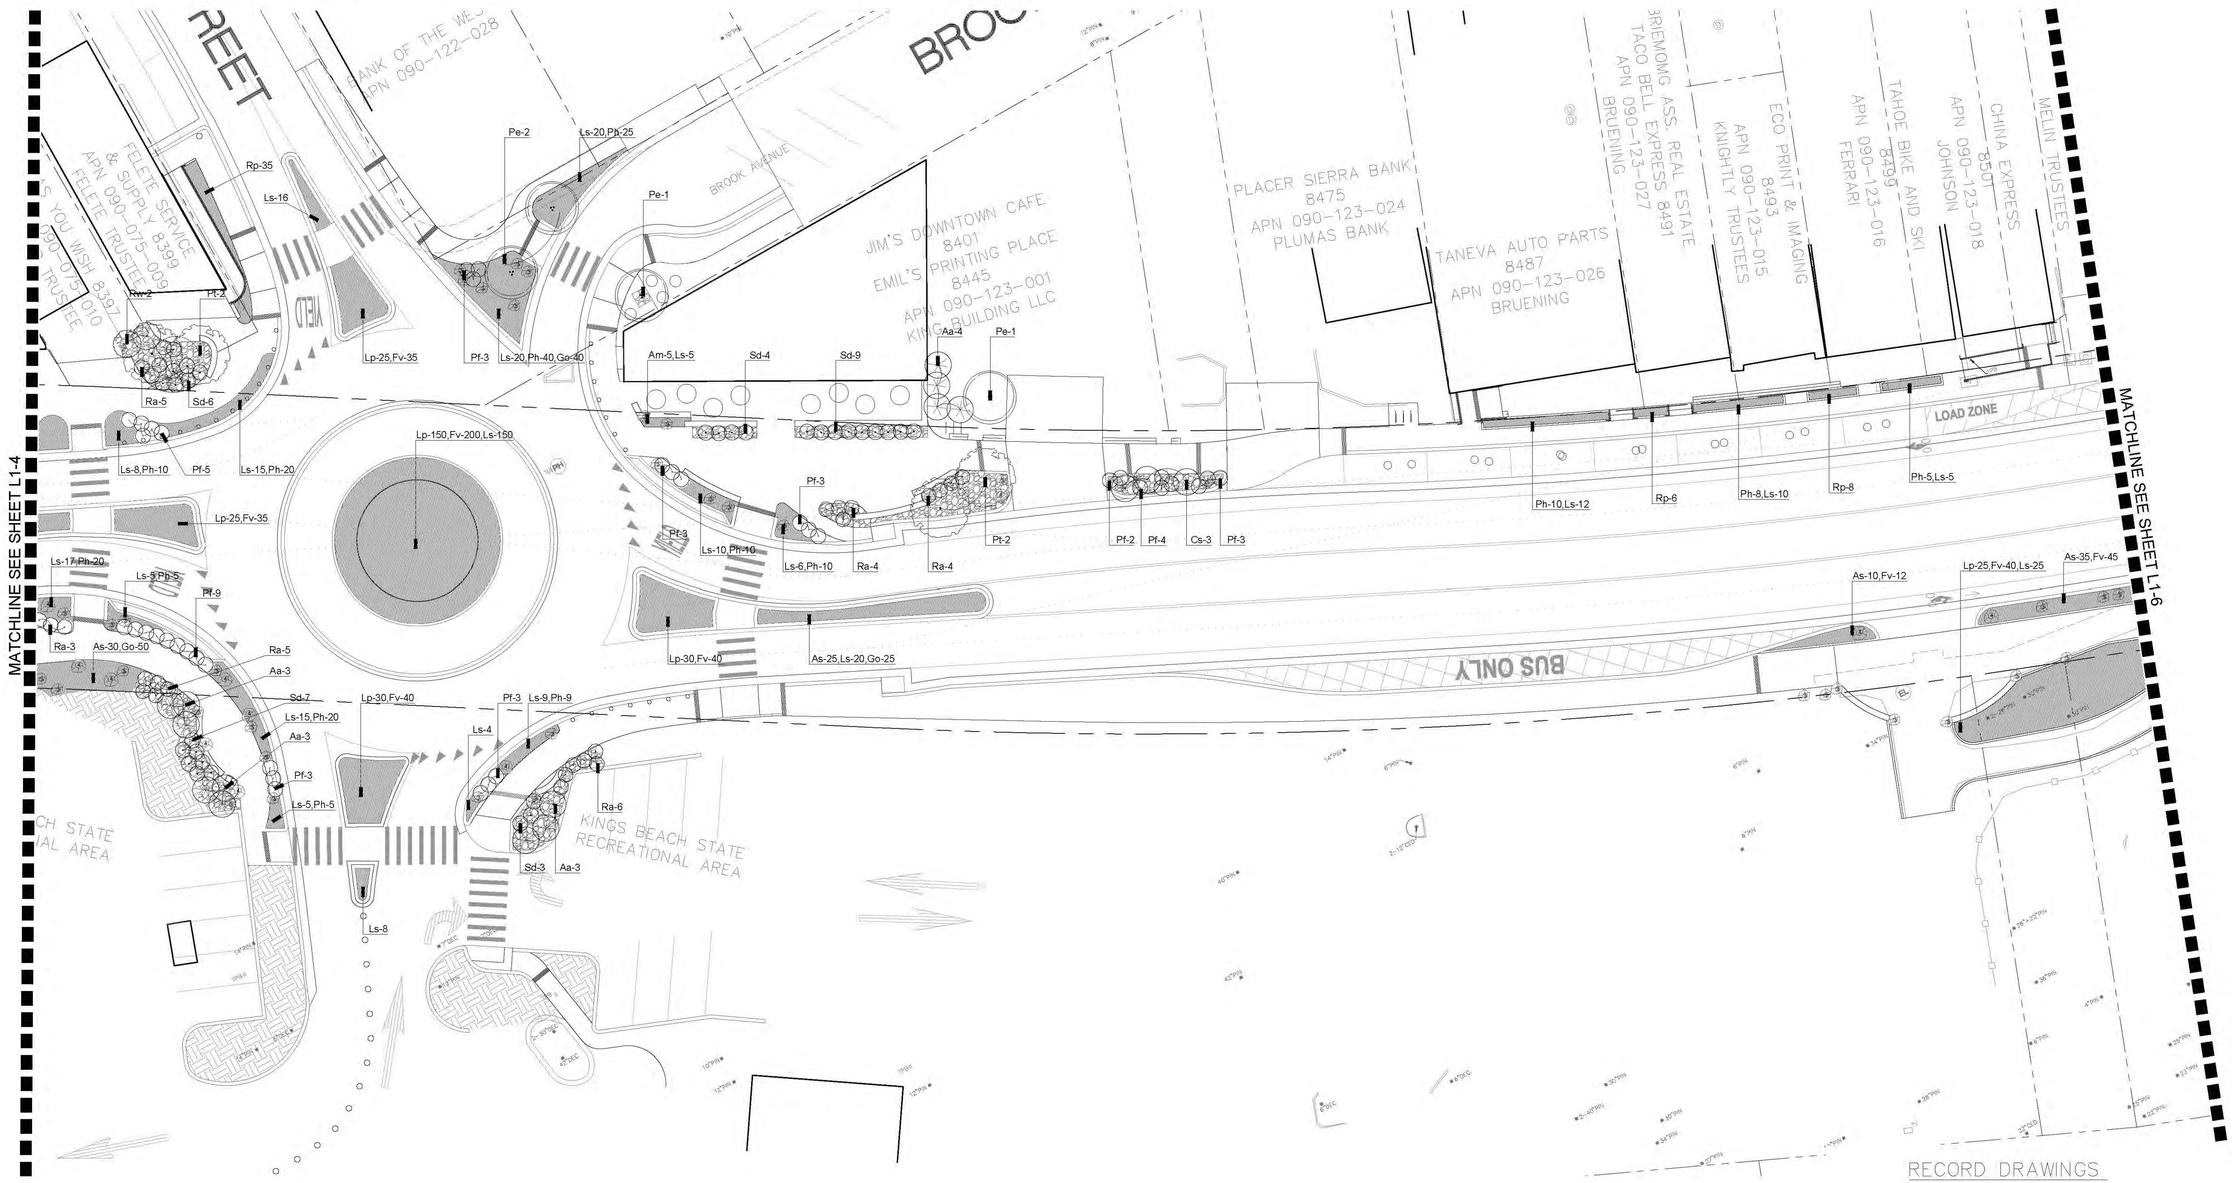

NORTH

0 10' 20' 40'
1"=20'

FOR REDUCED PLANS ORIGINAL SCALE IS IN INCHES

0 1 2 3

ALL DIMENSIONS SHOWN IN FEET UNLESS OTHERWISE NOTED

PHASE 3

INITIALS DATE

PLAN SCALE:
PROFILE SCALE:
HORIZ:
VERT:

DATE:
DESIGNED:
DRAWN:
CHECKED:
RECORD DRAWING:

CONTRACT NO. 1095

DESIGNWORKSHOP
LANDSCAPE ARCHITECTURE
PO Box 5666, 128 Market Street, Suite 3E
Stateline, Nevada 89449-5666
(775) 588-5929
WWW.DESIGNWORKSHOP.COM

COUNTY OF PLACER DEPARTMENT OF PUBLIC WORKS
KINGS BEACH COMMERCIAL CORE IMPROVEMENT PROJECT PHASE 3

LANDSCAPE MATERIALS PLANS

SHEET NO.
L1-5
OF

PLANT LEGEND

ABBR.	BOTANICAL NAME	COMMON NAME	QTY.	SIZE	COMMENTS
TREES					
Pe	Prunus emarginata	Bittercheery	1	2" Cal.	
Pt	Populus tremuloides	Aspen	6	2" - 3" Cal.	
Sc	Sorbus californica	Mountain Ash	10	2" Cal.	
SHRUBS					
Aa	Amelanchier alnifolia	Western Serviceberry	11	5 gal.	
Cs	Cprnus sericea	Redstem Dogwood	8	5 gal.	
Pf	Potentilla fruticosa	Shrubby cinquefoil	75	5 gal.	
Ra	Ribes nevadense	Mountain Currant	24	5 gal.	
Rw	Rosa woodsii	Woods Rose	4	5 gal.	
Sd	Spirea densoflora	Mountain Spirea	48	5 gal.	

ABBR.	BOTANICAL NAME	COMMON NAME	QTY.	SIZE	COMMENTS
Perennials					
Am	Achillea millefolium	Yarrow	0	1 gal.	
As	Aster alpinus	Alpine Aster	215	1 gal.	
Fv	Fragaria virginiana	Mountain Strawberry	370	1 gal.	
Go	Galium odoratum	Sweet Woodruff	100	1 gal.	
Lp	Lupinus polyphyllus	Large Leaved Lupine	420	1 gal.	
Ls	Leucanthemum x superbum	Shasta Daisy	370	1 gal.	
Ph	Penstemon newberryi	Penstemon, Mountain Pride	88	1 gal.	
Rp	Rubus parviflorus	Thimbleberry	211	1 gal.	

REVISION #	DATE:	DESCRIPTION AND SHEET NO.:	APPROVED BY:	DATE:

stamp

THE COUNTY OF PLACER OR ITS OFFICERS OR AGENTS SHALL NOT BE RESPONSIBLE FOR THE ACCURACY OR COMPLETENESS OF ELECTRONIC COPIES OF THIS PLAN SHEET.

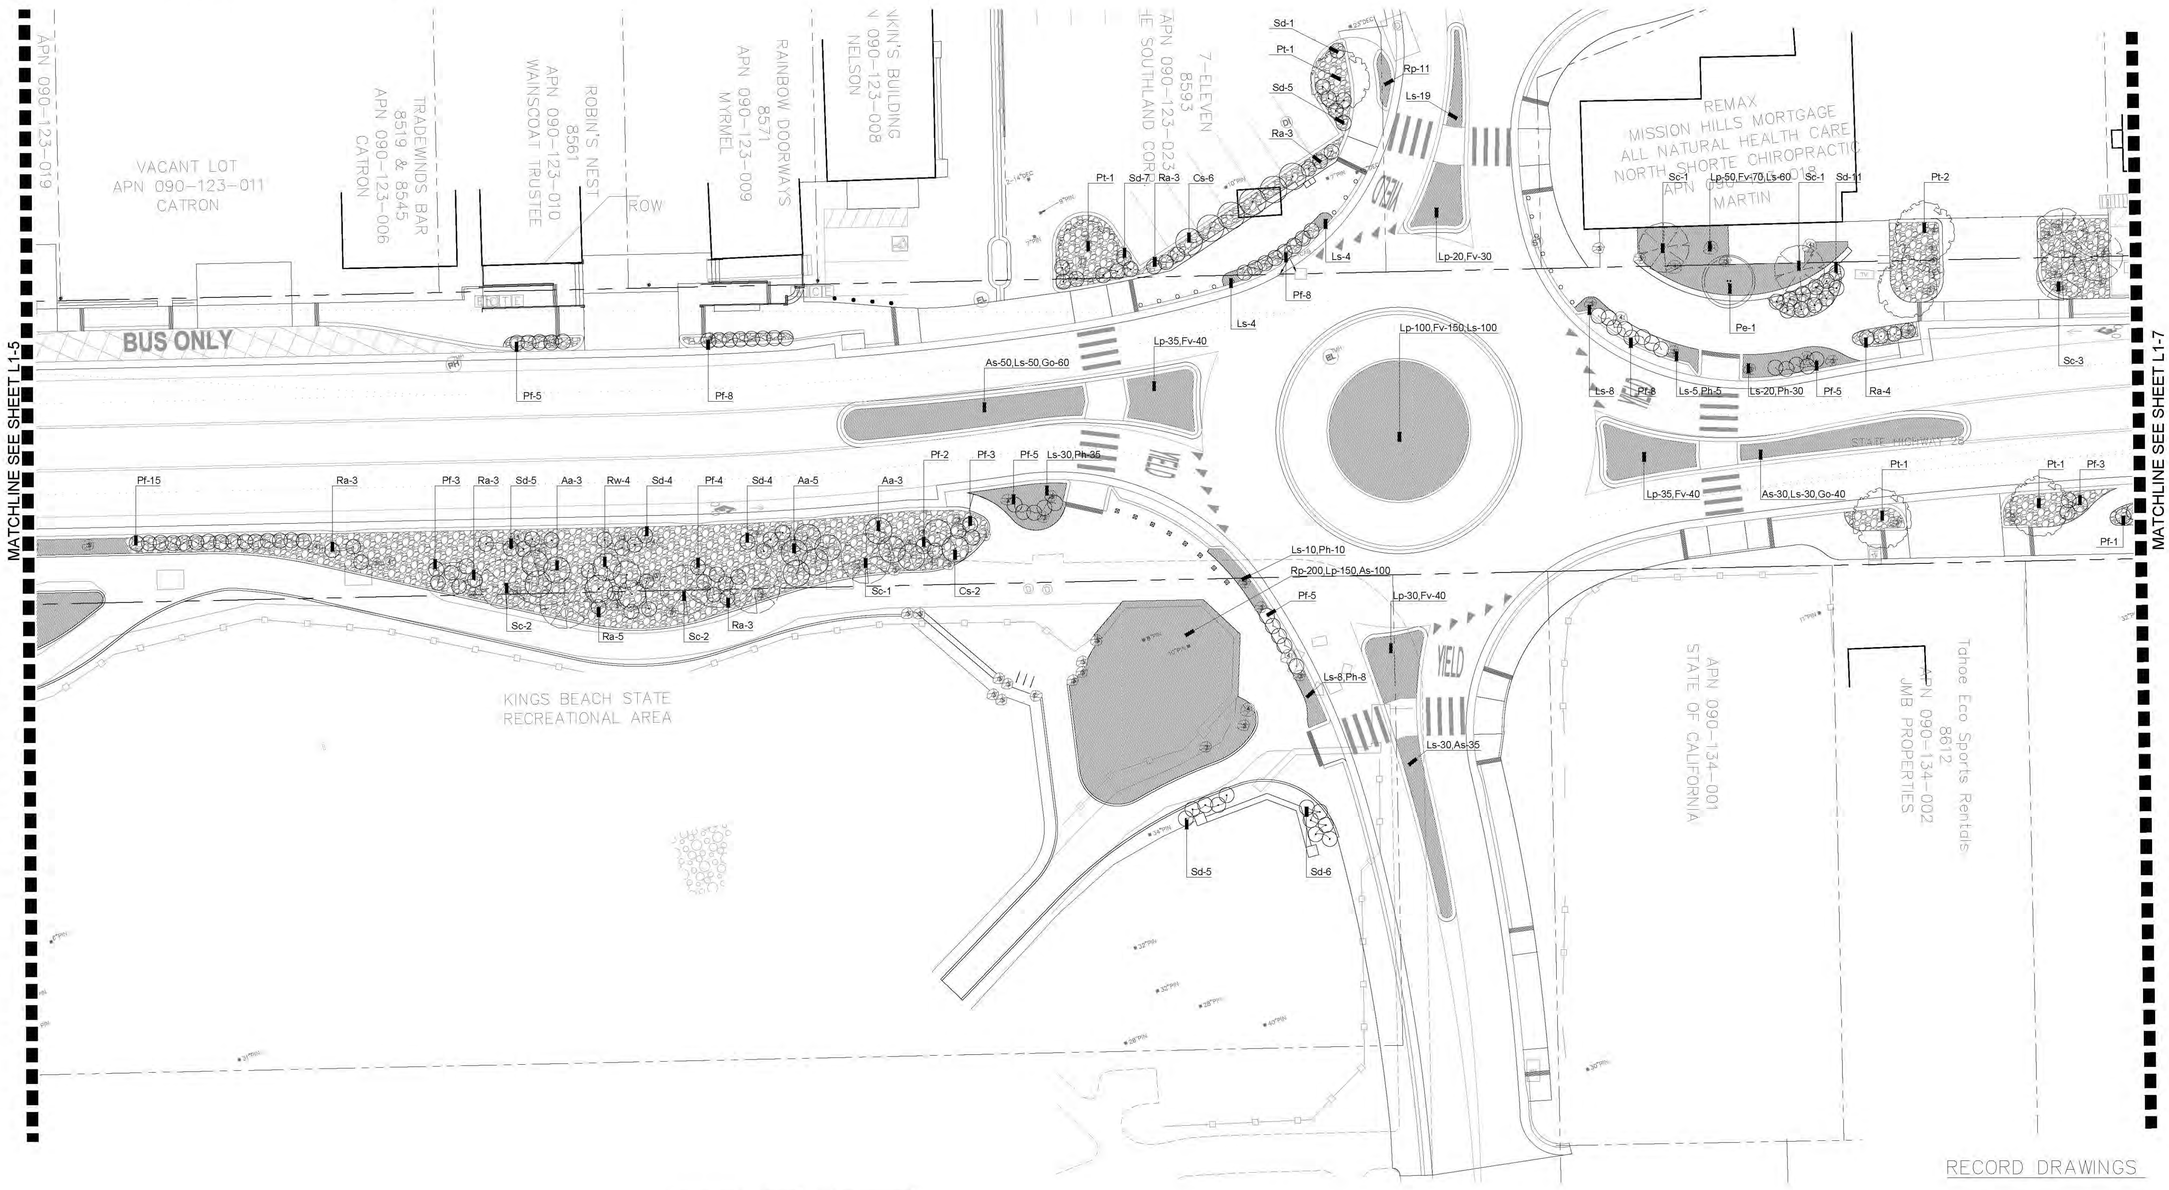

RECORD DRAWINGS

NORTH

0 10' 20' 40'
1"=20'

FOR REDUCED PLANS
ORIGINAL SCALE IS IN INCHES

0 1 2 3

ALL DIMENSIONS SHOWN IN FEET
UNLESS OTHERWISE NOTED

PHASE 3

INITIALS DATE

PLAN SCALE:
PROFILE SCALE:
HORIZ:
VERT:

DATE:
DESIGNED:
DRAWN:
CHECKED:
RECORD DRAWING:

CONTRACT NO.
1095

DESIGNWORKSHOP
LANDSCAPE ARCHITECTURE
PO Box 5666, 128 Market Street, Suite 3E
Stateline, Nevada 89449-5666
(775) 588-5929
WWW.DESIGNWORKSHOP.COM

COUNTY OF PLACER DEPARTMENT OF PUBLIC WORKS
KINGS BEACH COMMERCIAL CORE IMPROVEMENT PROJECT PHASE 3

LANDSCAPE MATERIALS PLANS

SHEET NO.
L1-6
OF

PLANT LEGEND

ABBR.	BOTANICAL NAME	COMMON NAME	QTY.	SIZE	COMMENTS
TREES					
Pe	Prunus emarginata	Bittercheery	2	2" Cal.	
Pt	Populus tremuloides	Aspen	12	2" - 3" Cal.	
Sc	Sorbus californica	Mountain Ash	2	2" Cal.	
SHRUBS					
Aa	Amelanchier alnifolia	Western Serviceberry	0	5 gal.	
Cs	Cprnus sericea	Redstem Dogwood	0	5 gal.	
Pf	Potentilla fruticosa	Shrubby cinquefoil	11	5 gal.	
Ra	Ribes nevadense	Mountain Currant	28	5 gal.	
Rw	Rosa woodsii	Woods Rose	0	5 gal.	
Sd	Spirea densoflora	Mountain Spirea	14	5 gal.	

ABBR.	BOTANICAL NAME	COMMON NAME	QTY.	SIZE	COMMENTS
Perennials					
Am	Achillea millefolium	Yarrow	20	1 gal.	
As	Aster alpinus	Alpine Aster	19	1 gal.	
Fv	Fragaria virginiana	Mountain Strawberry	30	1 gal.	
Go	Galium odoratum	Sweet Woodruff	19	1 gal.	
Lp	Lupinus polyphyllus	Large Leaved Lupine	65	1 gal.	
Ls	Leucanthemum x superbum	Shasta Daisy	0	1 gal.	
Ph	Penstemon newberryi	Penstemon, Mountain Pride	0	1 gal.	
Rp	Rubus parviflorus	Thimbleberry	110	1 gal.	

REVISION #	DATE:	DESCRIPTION AND SHEET NO.:	APPROVED BY:	DATE:

stamp

THE COUNTY OF PLACER OR ITS OFFICERS OR AGENTS SHALL NOT BE RESPONSIBLE FOR THE ACCURACY OR COMPLETENESS OF ELECTRONIC COPIES OF THIS PLAN SHEET.

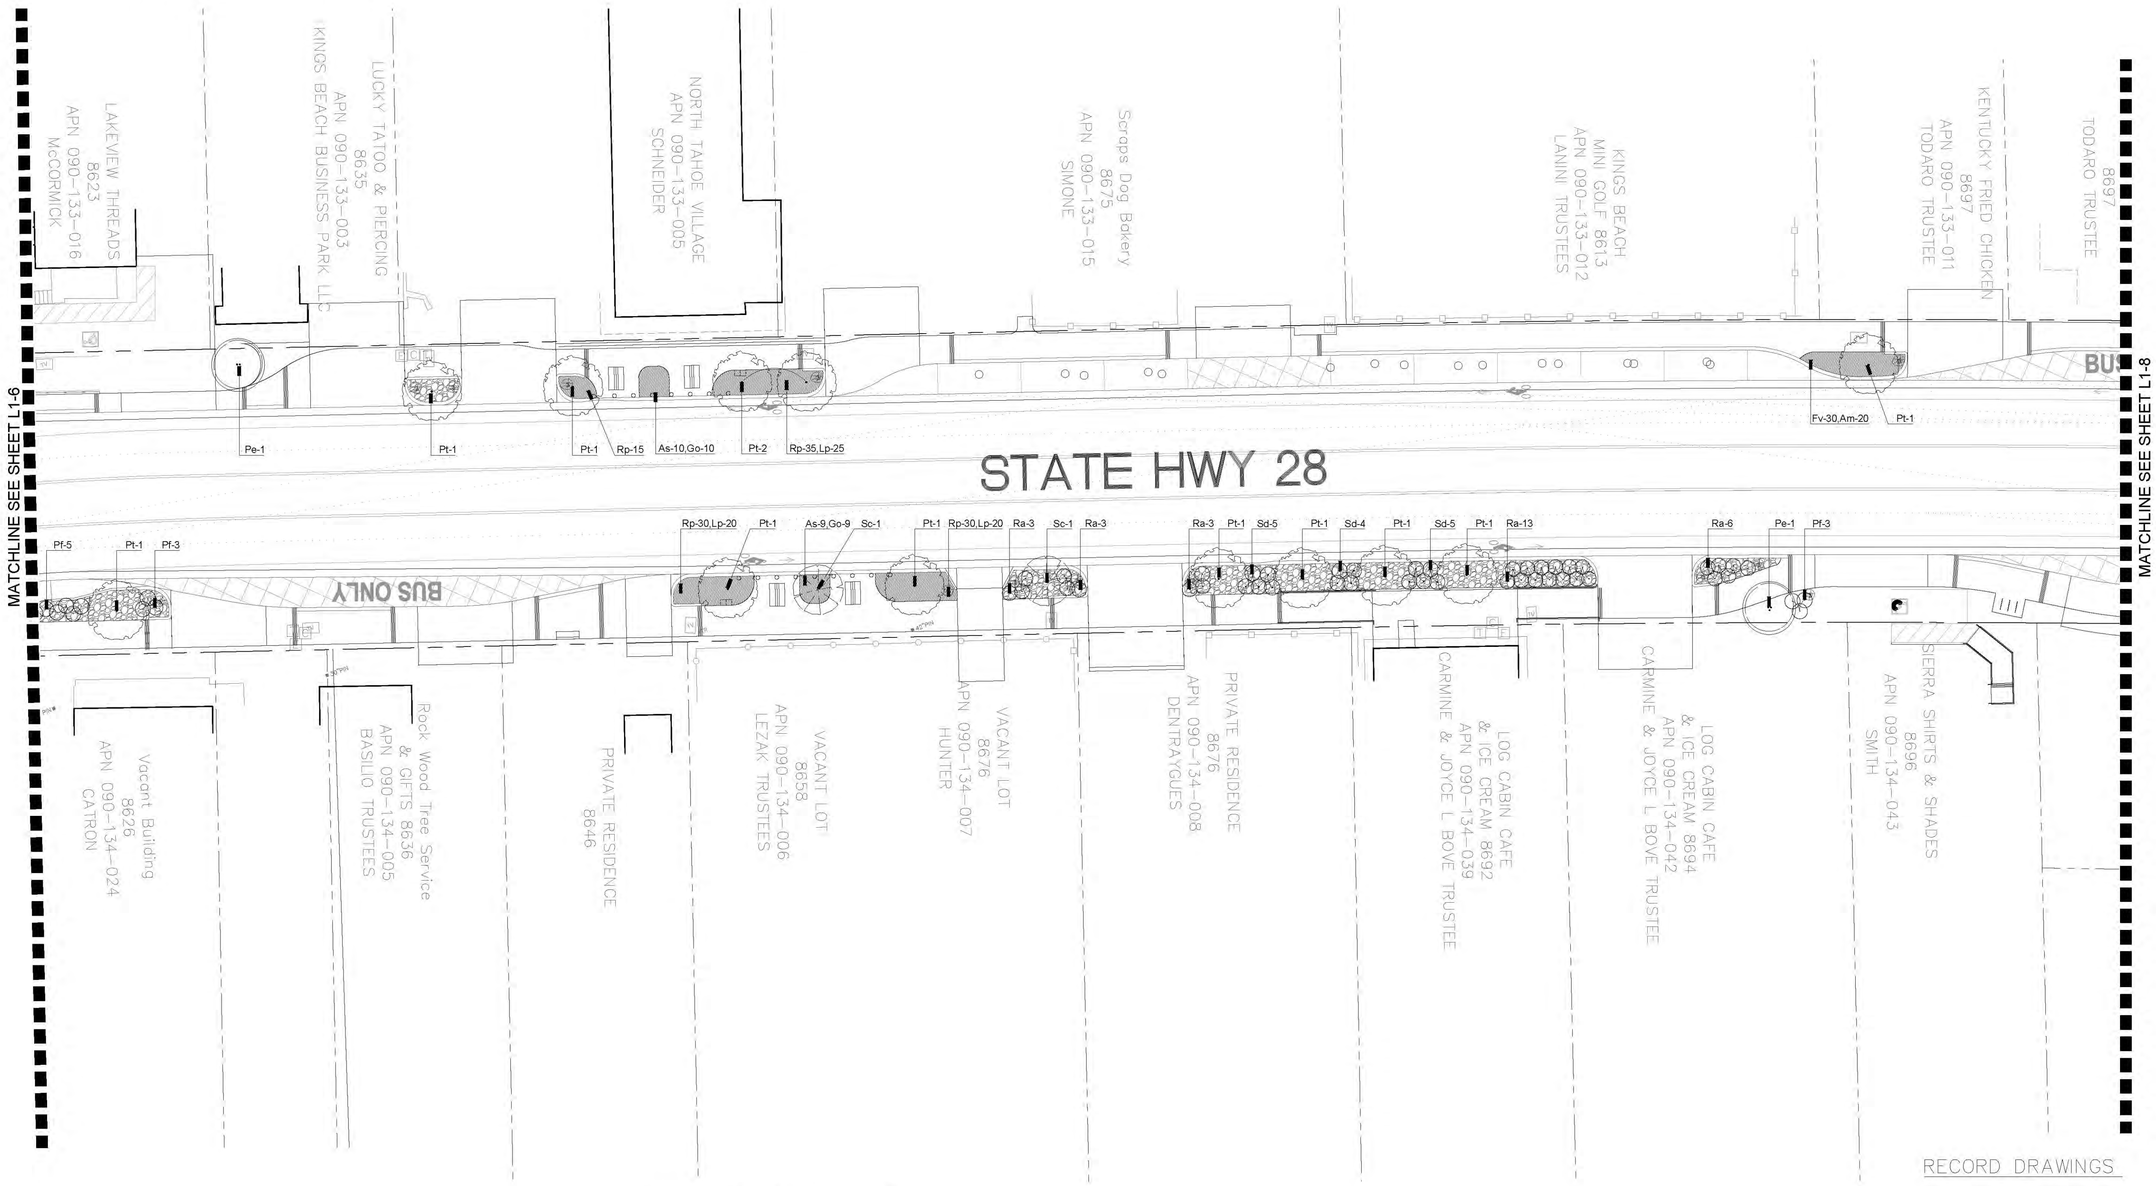

NORTH

0 10' 20' 40'
1"=20'

FOR REDUCED PLANS ORIGINAL SCALE IS IN INCHES

0 1 2 3

ALL DIMENSIONS SHOWN IN FEET UNLESS OTHERWISE NOTED

PHASE 3

INITIALS DATE

PLAN SCALE:
PROFILE SCALE:
HORIZ:
VERT:

DATE:
DESIGNED:
DRAWN:
CHECKED:
RECORD DRAWING:

CONTRACT NO. 1095

DESIGNWORKSHOP
LANDSCAPE ARCHITECTURE
PO Box 5666, 128 Market Street, Suite 3E
Stateline, Nevada 89449-5666
(775) 588-5929
WWW.DESIGNWORKSHOP.COM

COUNTY OF PLACER DEPARTMENT OF PUBLIC WORKS
KINGS BEACH COMMERCIAL CORE IMPROVEMENT PROJECT PHASE 3

LANDSCAPE MATERIALS PLANS

SHEET NO.
L1-7
OF

PLANT LEGEND

ABBR.	BOTANICAL NAME	COMMON NAME	QTY.	SIZE	COMMENTS
TREES					
Pe	Prunus emarginata	Bittercheery	0	2" Cal.	
Pt	Populus tremuloides	Aspen	5	2" - 3" Cal.	
Sc	Sorbus californica	Mountain Ash	1	2" Cal.	
SHRUBS					
Aa	Amelanchier alnifolia	Western Serviceberry	4	5 gal.	
Cs	Cprnus sericea	Redstem Dogwood	0	5 gal.	
Pf	Potentilla fruticosa	Shrubby cinquefoil	9	5 gal.	
Ra	Ribes nevadense	Mountain Currant	0	5 gal.	
Rw	Rosa woodsii	Woods Rose	0	5 gal.	
Sd	Spirea densoflora	Mountain Spirea	6	5 gal.	

ABBR.	BOTANICAL NAME	COMMON NAME	QTY.	SIZE	COMMENTS
Perennials					
Am	Achillea millefolium	Yarrow	20	1 gal.	
As	Aster alpinus	Alpine Aster	0	1 gal.	
Fv	Fragaria virginiana	Mountain Strawberry	20	1 gal.	
Go	Galium odoratum	Sweet Woodruff	0	1 gal.	
Lp	Lupinus polyphyllus	Large Leaved Lupine	0	1 gal.	
Ls	Leucanthemum x superbum	Shasta Daisy	50	1 gal.	
Ph	Penstemon newberryi	Penstemon, Mountain Pride	0	1 gal.	
Rp	Rubus parviflorus	Thimbleberry	70	1 gal.	

REVISION #	DATE:	DESCRIPTION AND SHEET NO.:	APPROVED BY:	DATE:

stamp

THE COUNTY OF PLACER OR ITS OFFICERS OR AGENTS SHALL NOT BE RESPONSIBLE FOR THE ACCURACY OR COMPLETENESS OF ELECTRONIC COPIES OF THIS PLAN SHEET.

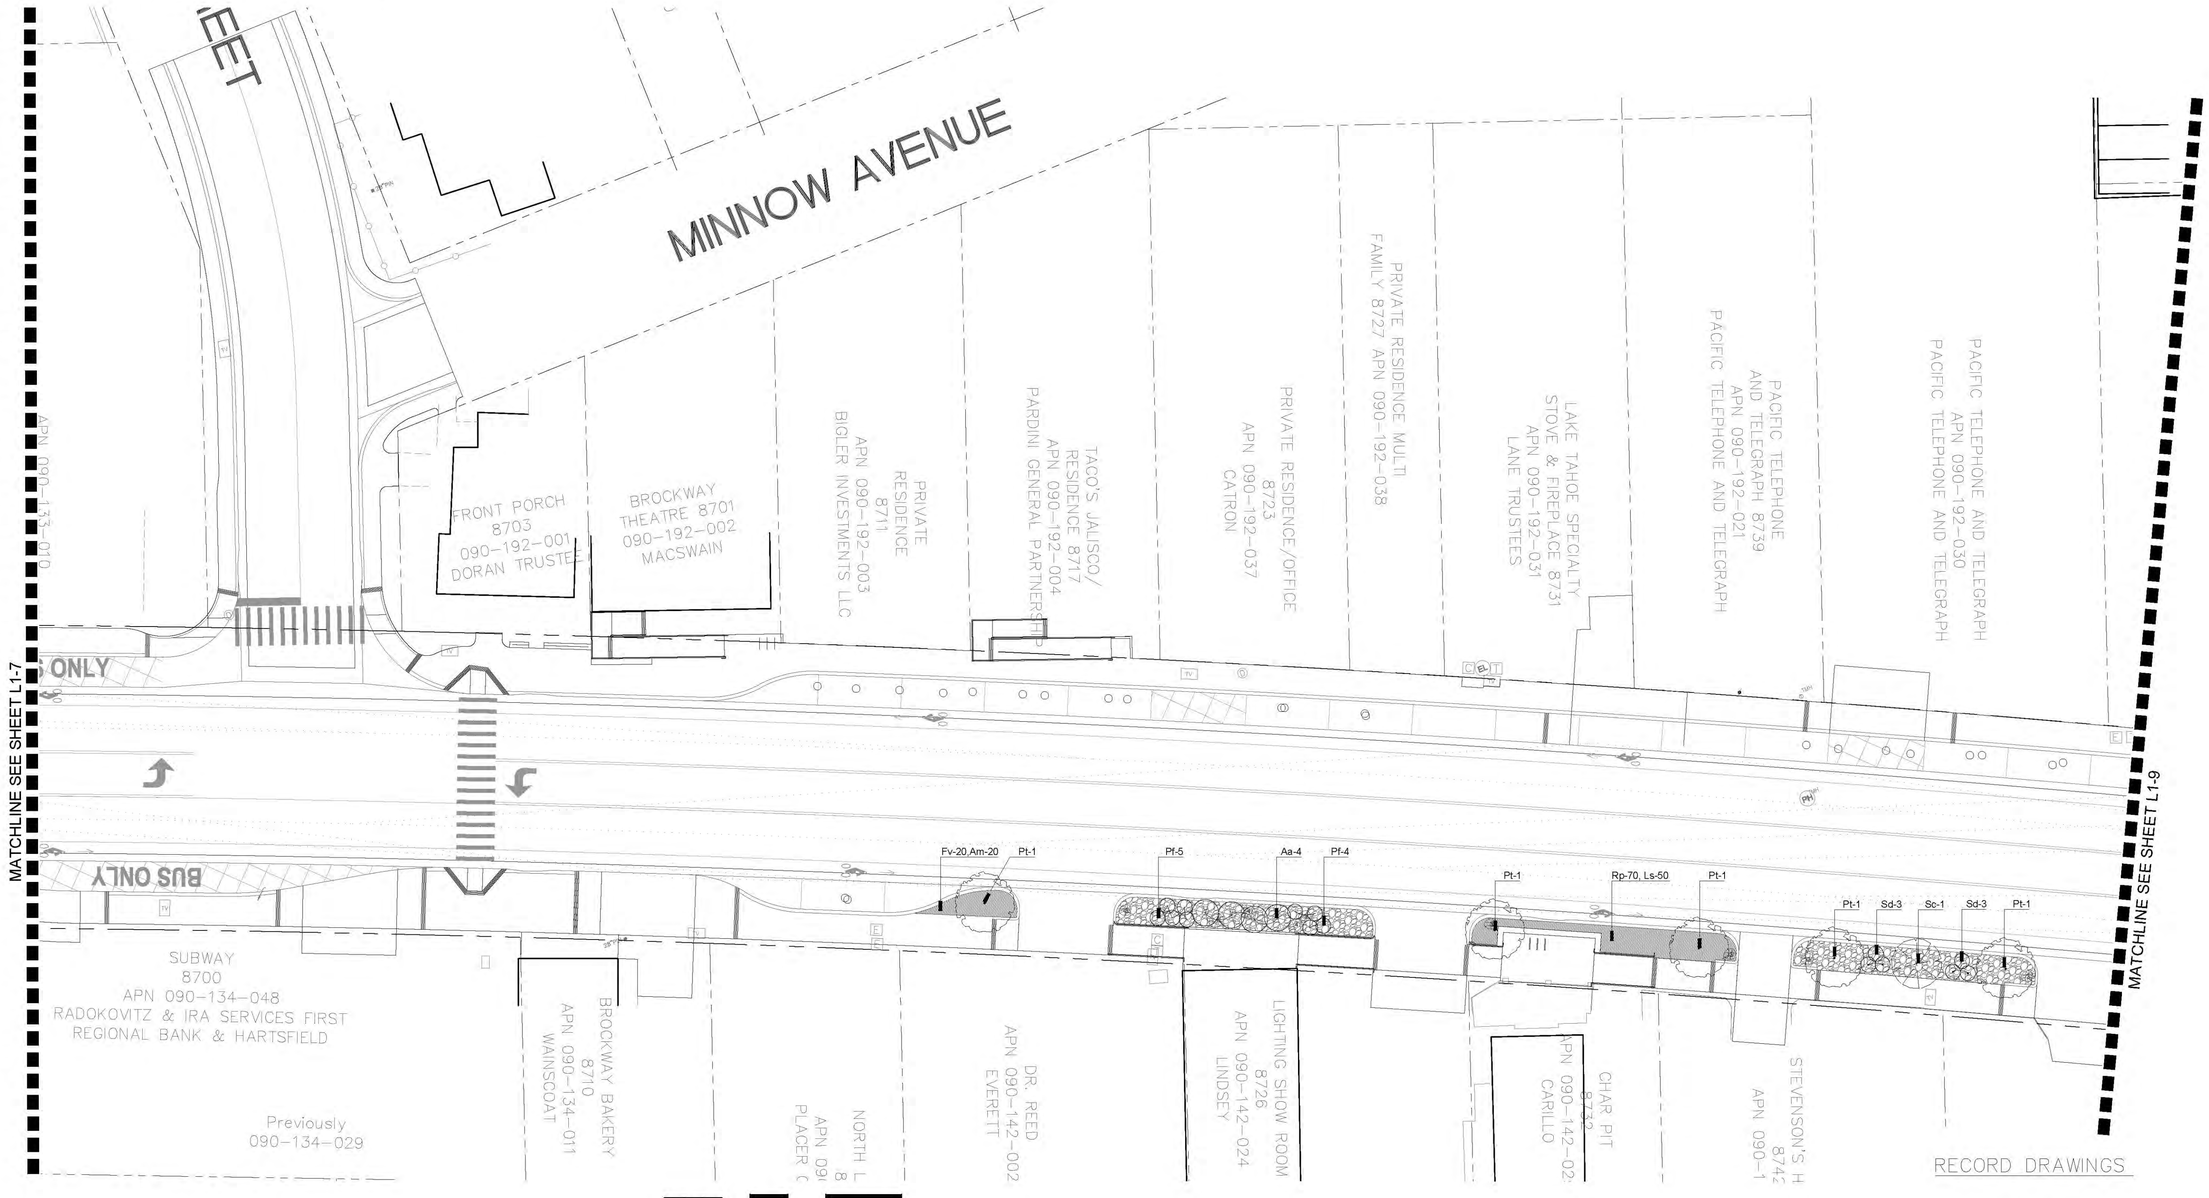

NORTH

0 10' 20' 40'
1"=20'

FOR REDUCED PLANS ORIGINAL SCALE IS IN INCHES

0 1 2 3

ALL DIMENSIONS SHOWN IN FEET UNLESS OTHERWISE NOTED

PHASE 3

INITIALS DATE

PLAN SCALE:
PROFILE SCALE:
HORIZ:
VERT:

DATE:
DESIGNED:
DRAWN:
CHECKED:
RECORD DRAWING:

CONTRACT NO. 1095

DESIGNWORKSHOP
LANDSCAPE ARCHITECTURE
PO Box 5666, 128 Market Street, Suite 3E
Stateline, Nevada 89449-5666
(775) 588-5929
WWW.DESIGNWORKSHOP.COM

COUNTY OF PLACER DEPARTMENT OF PUBLIC WORKS
KINGS BEACH COMMERCIAL CORE IMPROVEMENT PROJECT PHASE 3

LANDSCAPE MATERIALS PLANS

SHEET NO.
L1-8
OF

PLANT LEGEND

ABBR.	BOTANICAL NAME	COMMON NAME	QTY.	SIZE	COMMENTS
TREES					
Pe	Prunus emarginata	Bittercheery	0	2" Cal.	
Pt	Populus tremuloides	Aspen	7	2" - 3" Cal.	
Sc	Sorbus californica	Mountain Ash	2	2" Cal.	
SHRUBS					
Aa	Amelanchier alnifolia	Western Serviceberry	9	5 gal.	
Cs	Cprnus sericea	Redstem Dogwood	4	5 gal.	
Pf	Potentilla fruticosa	Shrubby cinquefoil	13	5 gal.	
Ra	Ribes nevadense	Mountain Currant	9	5 gal.	
Rw	Rosa woodsii	Woods Rose	0	5 gal.	
Sd	Spirea densoflora	Mountain Spirea	5	5 gal.	

ABBR.	BOTANICAL NAME	COMMON NAME	QTY.	SIZE	COMMENTS
Perennials					
Am	Achillea millefolium	Yarrow	0	1 gal.	
As	Aster alpinus	Alpine Aster	0	1 gal.	
Fv	Fragaria virginiana	Mountain Strawberry	85	1 gal.	
Go	Galium odoratum	Sweet Woodruff	0	1 gal.	
Lp	Lupinus polyphyllus	Large Leaved Lupine	60	1 gal.	
Ls	Leucanthemum x superbum	Shasta Daisy	0	1 gal.	
Ph	Penstemon newberryi	Penstemon, Mountain Pride	0	1 gal.	
Rp	Rubus parviflorus	Thimbleberry	0	1 gal.	

REVISION #	DATE:	DESCRIPTION AND SHEET NO.:	APPROVED BY:	DATE:

stamp

THE COUNTY OF PLACER OR ITS OFFICERS OR AGENTS SHALL NOT BE RESPONSIBLE FOR THE ACCURACY OR COMPLETENESS OF ELECTRONIC COPIES OF THIS PLAN SHEET.

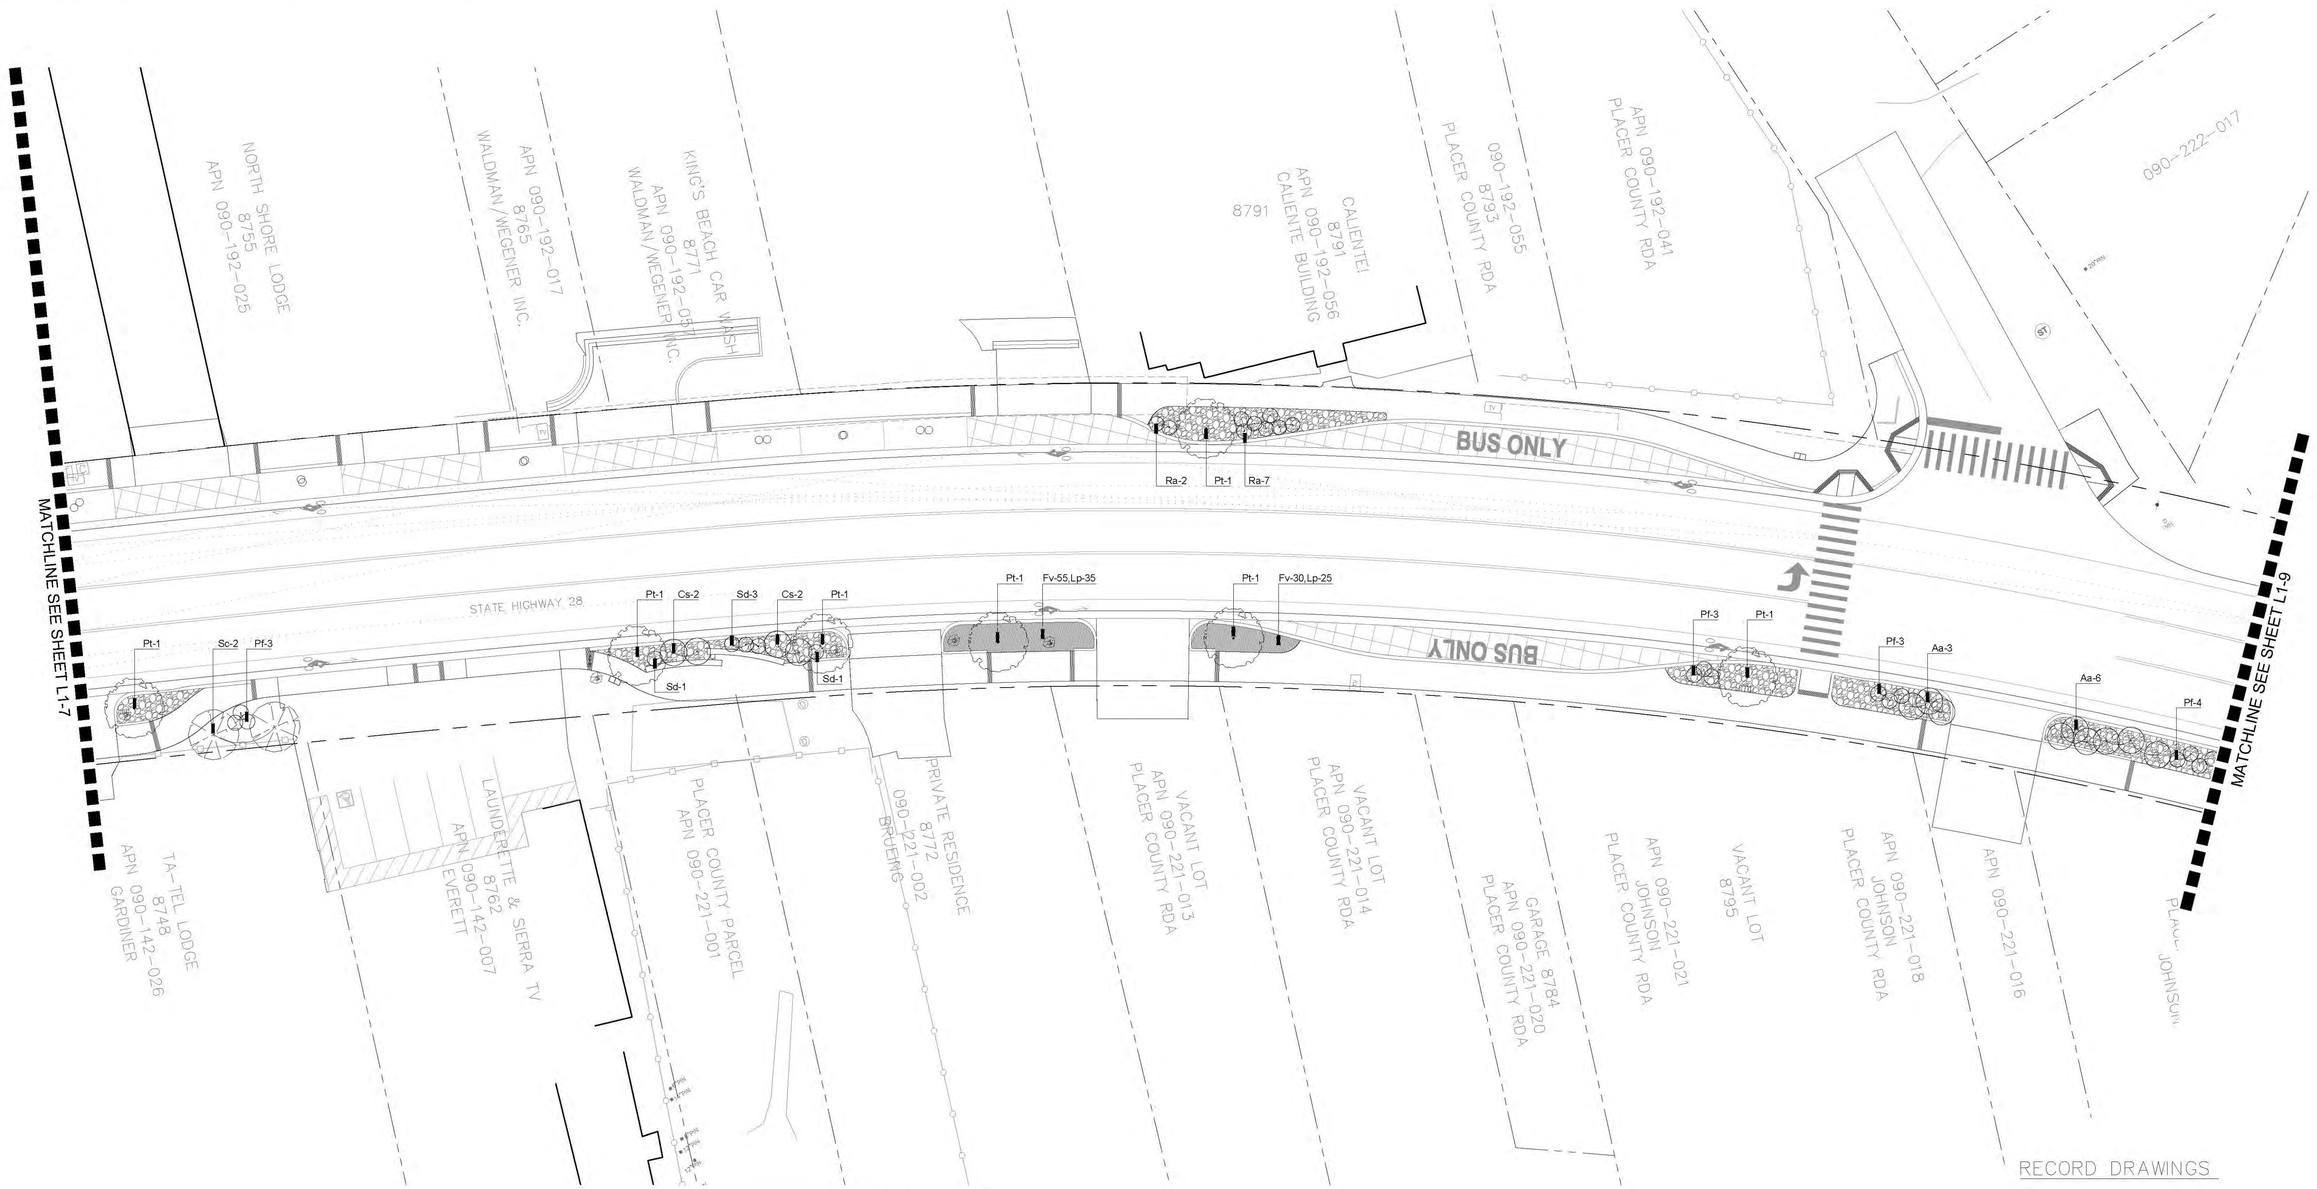

NORTH

0 10' 20' 40'
1"=20'

FOR REDUCED PLANS
ORIGINAL SCALE IS IN INCHES

0 1 2 3

ALL DIMENSIONS SHOWN IN FEET
UNLESS OTHERWISE NOTED

PHASE 3

INITIALS DATE

PLAN SCALE:
PROFILE SCALE:
HORIZ:
VERT:

DATE:
DESIGNED:
DRAWN:
CHECKED:
RECORD DRAWING:

CONTRACT NO.
1095

DESIGNWORKSHOP
LANDSCAPE ARCHITECTURE
PO Box 5666, 128 Market Street, Suite 3E
Stateline, Nevada 89449-5666
(775) 588-5929
WWW.DESIGNWORKSHOP.COM

COUNTY OF PLACER DEPARTMENT OF PUBLIC WORKS
KINGS BEACH COMMERCIAL CORE IMPROVEMENT PROJECT PHASE 3

LANDSCAPE MATERIALS PLANS

SHEET NO.
L1-9
OF

PLANT LEGEND

ABBR.	BOTANICAL NAME	COMMON NAME	QTY.	SIZE	COMMENTS
TREES					
Pe	Prunus emarginata	Bittercheery	0	2" Cal.	
Pt	Populus tremuloides	Aspen	0	2" - 3" Cal.	
Sc	Sorbus californica	Mountain Ash	0	2" Cal.	
SHRUBS					
Aa	Amelanchier alnifolia	Western Serviceberry	3	5 gal.	
Cs	Cprnus sericea	Redstem Dogwood	5	5 gal.	
Pf	Potentilla fruticosa	Shrubby cinquefoil	13	5 gal.	
Ra	Ribes nevadense	Mountain Currant	0	5 gal.	
Rw	Rosa woodsii	Woods Rose	0	5 gal.	
Sd	Spirea densoflora	Mountain Spirea	0	5 gal.	

ABBR.	BOTANICAL NAME	COMMON NAME	QTY.	SIZE	COMMENTS
Perennials					
Am	Achillea millefolium	Yarrow	0	1 gal.	
As	Aster alpinus	Alpine Aster	0	1 gal.	
Fv	Fragaria virginiana	Mountain Strawberry	0	1 gal.	
Go	Galium odoratum	Sweet Woodruff	0	1 gal.	
Lp	Lupinus polyphyllus	Large Leaved Lupine	0	1 gal.	
Ls	Leucanthemum x superbum	Shasta Daisy	0	1 gal.	
Ph	Penstemon newberryi	Penstemon, Mountain Pride	0	1 gal.	
Rp	Rubus parviflorus	Thimbleberry	0	1 gal.	

REVISION #	DATE:	DESCRIPTION AND SHEET NO.:	APPROVED BY:	DATE:

stamp

THE COUNTY OF PLACER OR ITS OFFICERS OR AGENTS SHALL NOT BE RESPONSIBLE FOR THE ACCURACY OR COMPLETENESS OF ELECTRONIC COPIES OF THIS PLAN SHEET.

NORTH

0 10' 20' 40'
1"=20'

FOR REDUCED PLANS
ORIGINAL SCALE IS IN INCHES

0 1 2 3

ALL DIMENSIONS SHOWN IN FEET
UNLESS OTHERWISE NOTED

PHASE 3

INITIALS DATE

PLAN SCALE:
PROFILE SCALE:
HORIZ:
VERT:

DATE:
DESIGNED:
DRAWN:
CHECKED:
RECORD DRAWING:

CONTRACT NO. 1095

DESIGNWORKSHOP
LANDSCAPE ARCHITECTURE
PO Box 5666, 128 Market Street, Suite 3E
Stateline, Nevada 89449-5666
(775) 588-5929
WWW.DESIGNWORKSHOP.COM

COUNTY OF PLACER DEPARTMENT OF PUBLIC WORKS
KINGS BEACH COMMERCIAL CORE IMPROVEMENT PROJECT PHASE 3

LANDSCAPE MATERIALS PLANS

SHEET NO.
L1-10
OF

PLANT LEGEND

ABBR.	BOTANICAL NAME	COMMON NAME	QTY.	SIZE	COMMENTS
TREES					
Pe	Prunus emarginata	Bittercheery	x	2" Cal.	
Pt	Populus tremuloides	Aspen	x	2" - 3" Cal.	
Sc	Sorbus californica	Mountain Ash	x	2" Cal.	
SHRUBS					
Aa	Amelanchier alnifolia	Western Serviceberry	x	5 gal.	
Cs	Cprnus sericea	Redstem Dogwood	x	5 gal.	
Pf	Potentilla fruticosa	Shrubby cinquefoil	x	5 gal.	
Ra	Ribes nevadense	Mountain Currant	x	5 gal.	
Rw	Rosa woodsii	Woods Rose	x	5 gal.	
Sd	Spirea densoflora	Mountain Spirea	x	5 gal.	

ABBR.	BOTANICAL NAME	COMMON NAME	QTY.	SIZE	COMMENTS
Perennials					
Am	Achillea millefolium	Yarrow	x	1 gal.	
As	Aster alpinus	Alpine Aster	x	1 gal.	
Fv	Fragaria virginiana	Mountain Strawberry	x	1 gal.	
Go	Galium odoratum	Sweet Woodruff	x	1 gal.	
Lp	Lupinus polyphyllus	Large Leaved Lupine	x	1 gal.	
Ls	Leucanthemum x superbum	Shasta Daisy	x	1 gal.	
Ph	Penstemon newberryi	Penstemon, Mountain Pride	x	1 gal.	
Rp	Rubus parviflorus	Thimbleberry	x	1 gal.	

REVISION #	DATE:	DESCRIPTION AND SHEET NO.:	APPROVED BY:	DATE:

stamp

THE COUNTY OF PLACER OR ITS OFFICERS OR AGENTS SHALL NOT BE RESPONSIBLE FOR THE ACCURACY OR COMPLETENESS OF ELECTRONIC COPIES OF THIS PLAN SHEET.

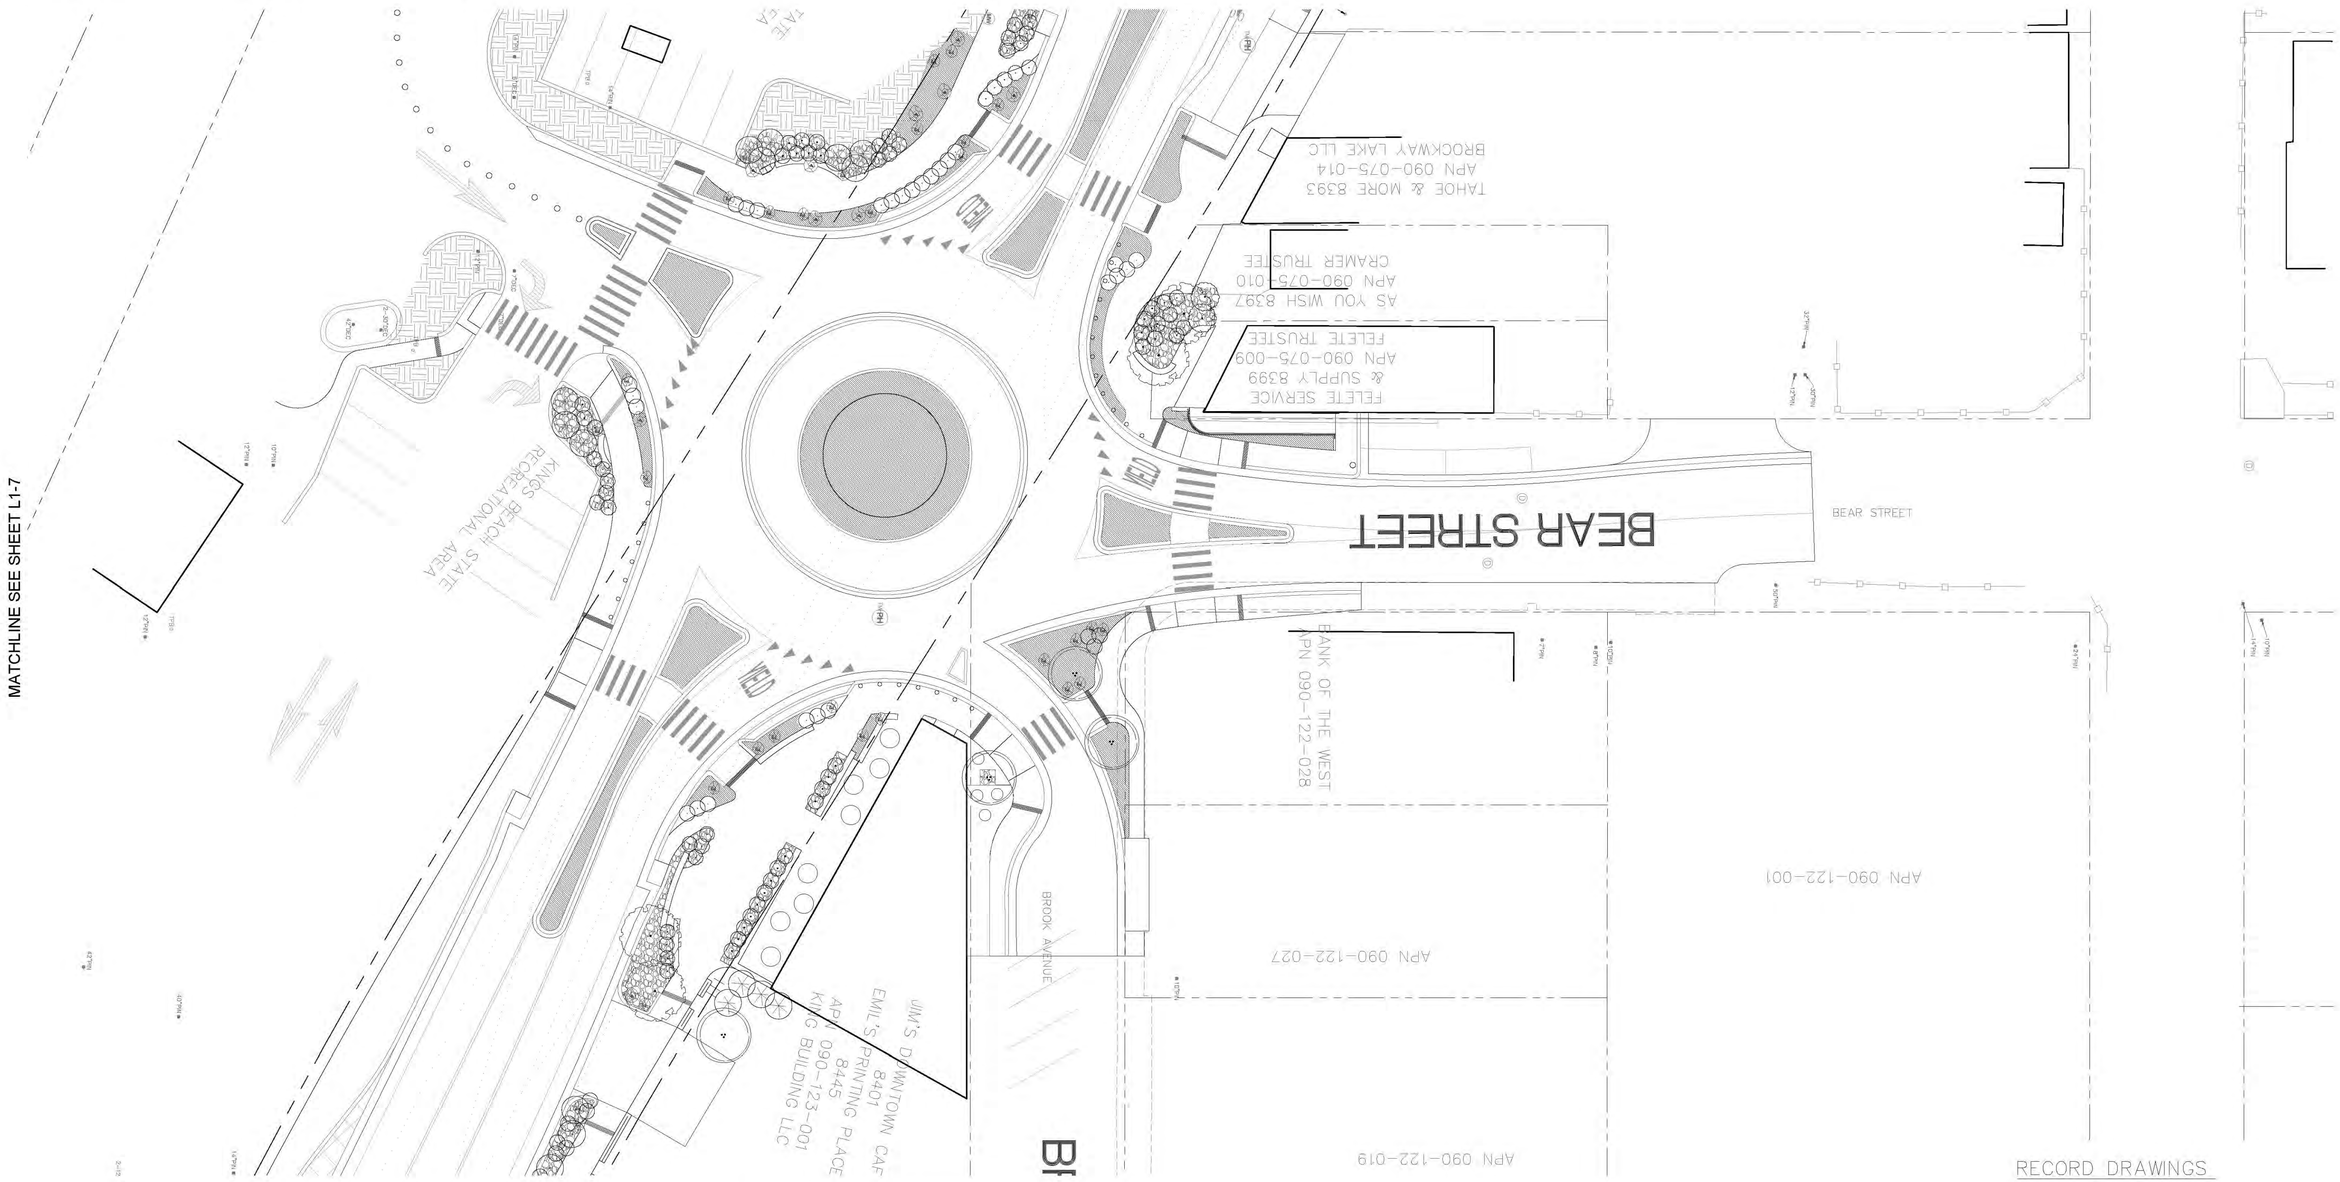

FOR REDUCED PLANS ORIGINAL SCALE IS IN INCHES

ALL DIMENSIONS SHOWN IN FEET UNLESS OTHERWISE NOTED

PHASE 3

INITIALS DATE

PLAN SCALE:
PROFILE SCALE:
HORIZ:
VERT:

DATE:
DESIGNED:
DRAWN:
CHECKED:
RECORD DRAWING:

CONTRACT NO. 1095

DESIGNWORKSHOP
LANDSCAPE ARCHITECTURE
PO Box 5666, 128 Market Street, Suite 3E
Stateline, Nevada 89449-5666
(775) 588-5929
WWW.DESIGNWORKSHOP.COM

COUNTY OF PLACER DEPARTMENT OF PUBLIC WORKS
KINGS BEACH COMMERCIAL CORE IMPROVEMENT PROJECT PHASE 3

LANDSCAPE MATERIALS PLANS

SHEET NO.
L1-11
OF

PLANT LEGEND

ABBR.	BOTANICAL NAME	COMMON NAME	QTY.	SIZE	COMMENTS
TREES					
Pe	Prunus emarginata	Bittercheery	x	2" Cal.	
Pt	Populus tremuloides	Aspen	x	2" - 3" Cal.	
Sc	Sorbus californica	Mountain Ash	x	2" Cal.	
SHRUBS					
Aa	Amelanchier alnifolia	Western Serviceberry	x	5 gal.	
Cs	Cprnus sericea	Redstem Dogwood	x	5 gal.	
Pf	Potentilla fruticosa	Shrubby cinquefoil	x	5 gal.	
Ra	Ribes nevadense	Mountain Currant	x	5 gal.	
Rw	Rosa woodsii	Woods Rose	x	5 gal.	
Sd	Spirea densoflora	Mountain Spirea	x	5 gal.	

ABBR.	BOTANICAL NAME	COMMON NAME	QTY.	SIZE	COMMENTS
Perennials					
Am	Achillea millefolium	Yarrow	x	1 gal.	
As	Aster alpinus	Alpine Aster	x	1 gal.	
Fv	Fragaria virginiana	Mountain Strawberry	x	1 gal.	
Go	Galium odoratum	Sweet Woodruff	x	1 gal.	
Lp	Lupinus polyphyllus	Large Leaved Lupine	x	1 gal.	
Ls	Leucanthemum x superbum	Shasta Daisy	x	1 gal.	
Ph	Penstemon newberryi	Penstemon, Mountain Pride	x	1 gal.	
Rp	Rubus parviflorus	Thimbleberry	x	1 gal.	

REVISION #	DATE:	DESCRIPTION AND SHEET NO.:	APPROVED BY:	DATE:

stamp

THE COUNTY OF PLACER OR ITS OFFICERS OR AGENTS SHALL NOT BE RESPONSIBLE FOR THE ACCURACY OR COMPLETENESS OF ELECTRONIC COPIES OF THIS PLAN SHEET.

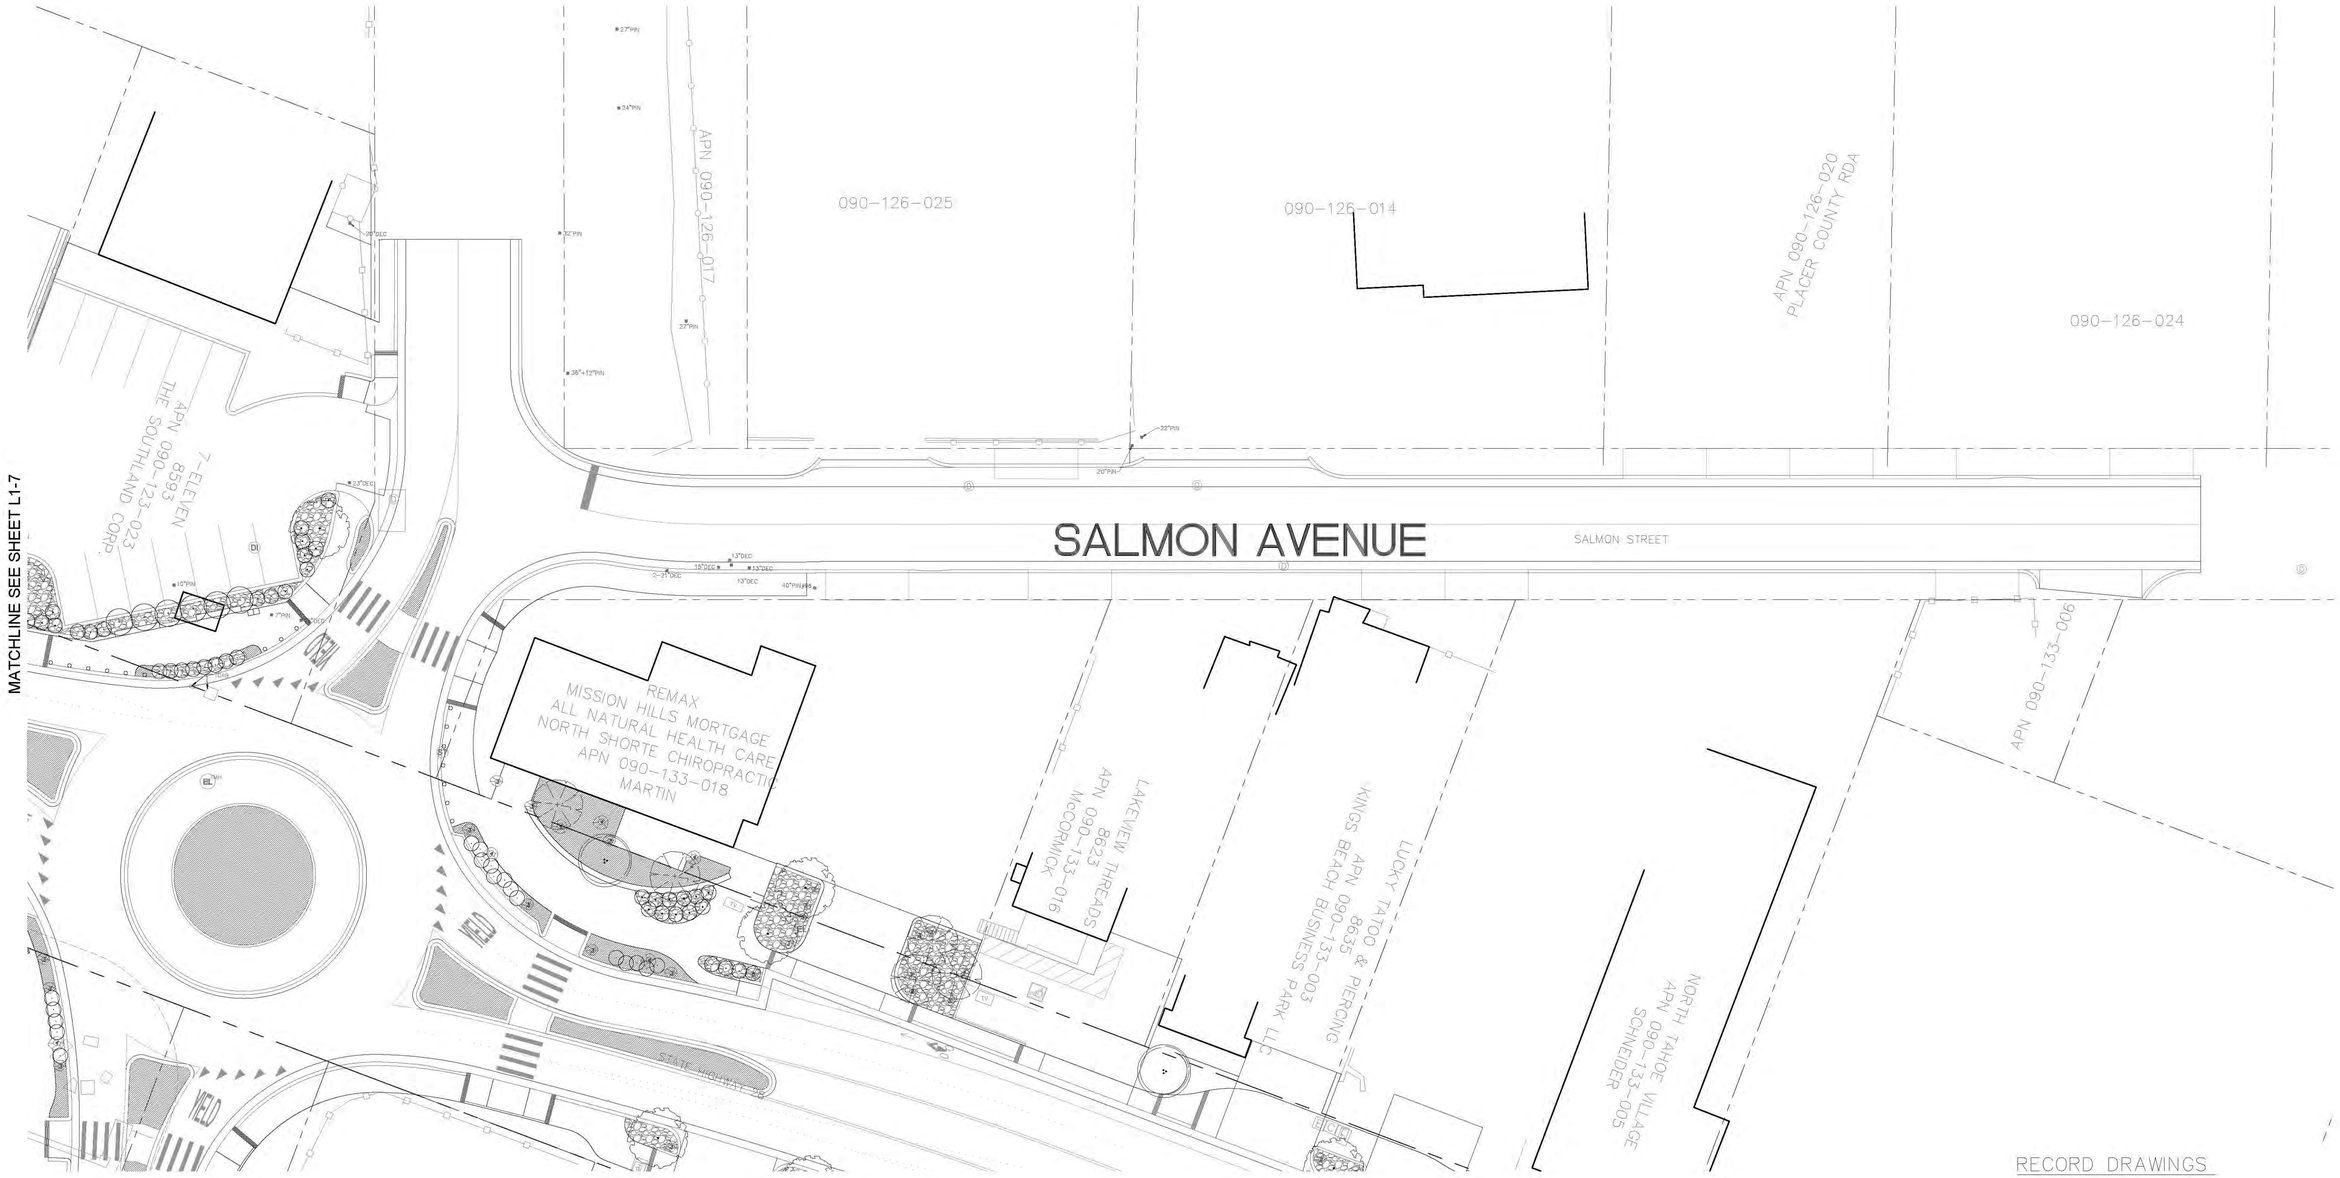

NORTH

0 10' 20' 40'
1"=20'

FOR REDUCED PLANS
ORIGINAL SCALE IS IN INCHES

0 1 2 3

ALL DIMENSIONS SHOWN IN FEET
UNLESS OTHERWISE NOTED

PHASE 3

INITIALS DATE

PLAN SCALE:
PROFILE SCALE:
HORIZ:
VERT:

DATE:
DESIGNED:
DRAWN:
CHECKED:
RECORD DRAWING:

CONTRACT NO.
1095

DESIGNWORKSHOP
LANDSCAPE ARCHITECTURE
PO Box 5666, 128 Market Street, Suite 3E
Stateline, Nevada 89449-5666
(775) 588-5929
WWW.DESIGNWORKSHOP.COM

COUNTY OF PLACER DEPARTMENT OF PUBLIC WORKS
KINGS BEACH COMMERCIAL CORE IMPROVEMENT PROJECT PHASE 3

LANDSCAPE MATERIALS PLANS

SHEET NO.
L1-12
OF