Document Number _____

~~City~~ of Todd Valley County of PLACER, California

Brief Legal Description 16/PM/77, N/MAPS/16 + K/MAPS/20

CORNER TYPE

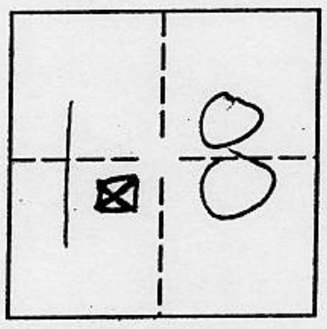

T 13N
R 10E
M.D.M.

Government Corner	☐	Control	☐
Meander	☐	Property	☒
Rancho	☐	Other	☐

Date of Survey Oct. 2001

COORDINATES(Optional)

N. _____
E. _____
Zone _____ NAD27 ☐ NAD83 ☐
NAD83 Epoch _____
Elevation _____
Vert. Datum: NGVD29 ☐ NAV88 ☐
Meas. Units: Metric ☐ Imperial ☐

Corner - Left as found ☒ Found and tagged ☐ Established ☐ Reestablished ☒ Rebuilt ☐

Identification and type of corner found: Evidence used to identify or procedure used to establish or reestablish the corner:

see sketch sheet 2

A description of the physical condition of the monument as found and as set or reset:

see sketch sheet 2

SURVEYOR'S STATEMENT

This Corner Record was prepared by me or under my direction in conformance with the Land Surveyor's Act on Dec 20, 2001.

Signed _____ P.L.S. or R.C.E. Number _____

LICENSED LAND SURVEYOR MARC R. VAN ZUUK No. 6230 Exp. 31 Mar 2002 STATE OF CALIFORNIA

COUNTY SURVEYOR'S STATEMENT

This Corner Record was received January 7th, 2002 and examined and filed MARCH 13TH, 2002.

Signed _____ P.L.S. ~~or R.C.E.~~ Number 4323

Title COUNTY SURVEYOR

County Surveyor's Comment _____

SEAL

LICENSED LAND SURVEYOR JOHN H. RIETJENS 6-30-2004 L.S. 4323 STATE OF CALIFORNIA

Book 7 of Corner Records Page 37

BOOK 7 CORNER RECORDS PAGE 37

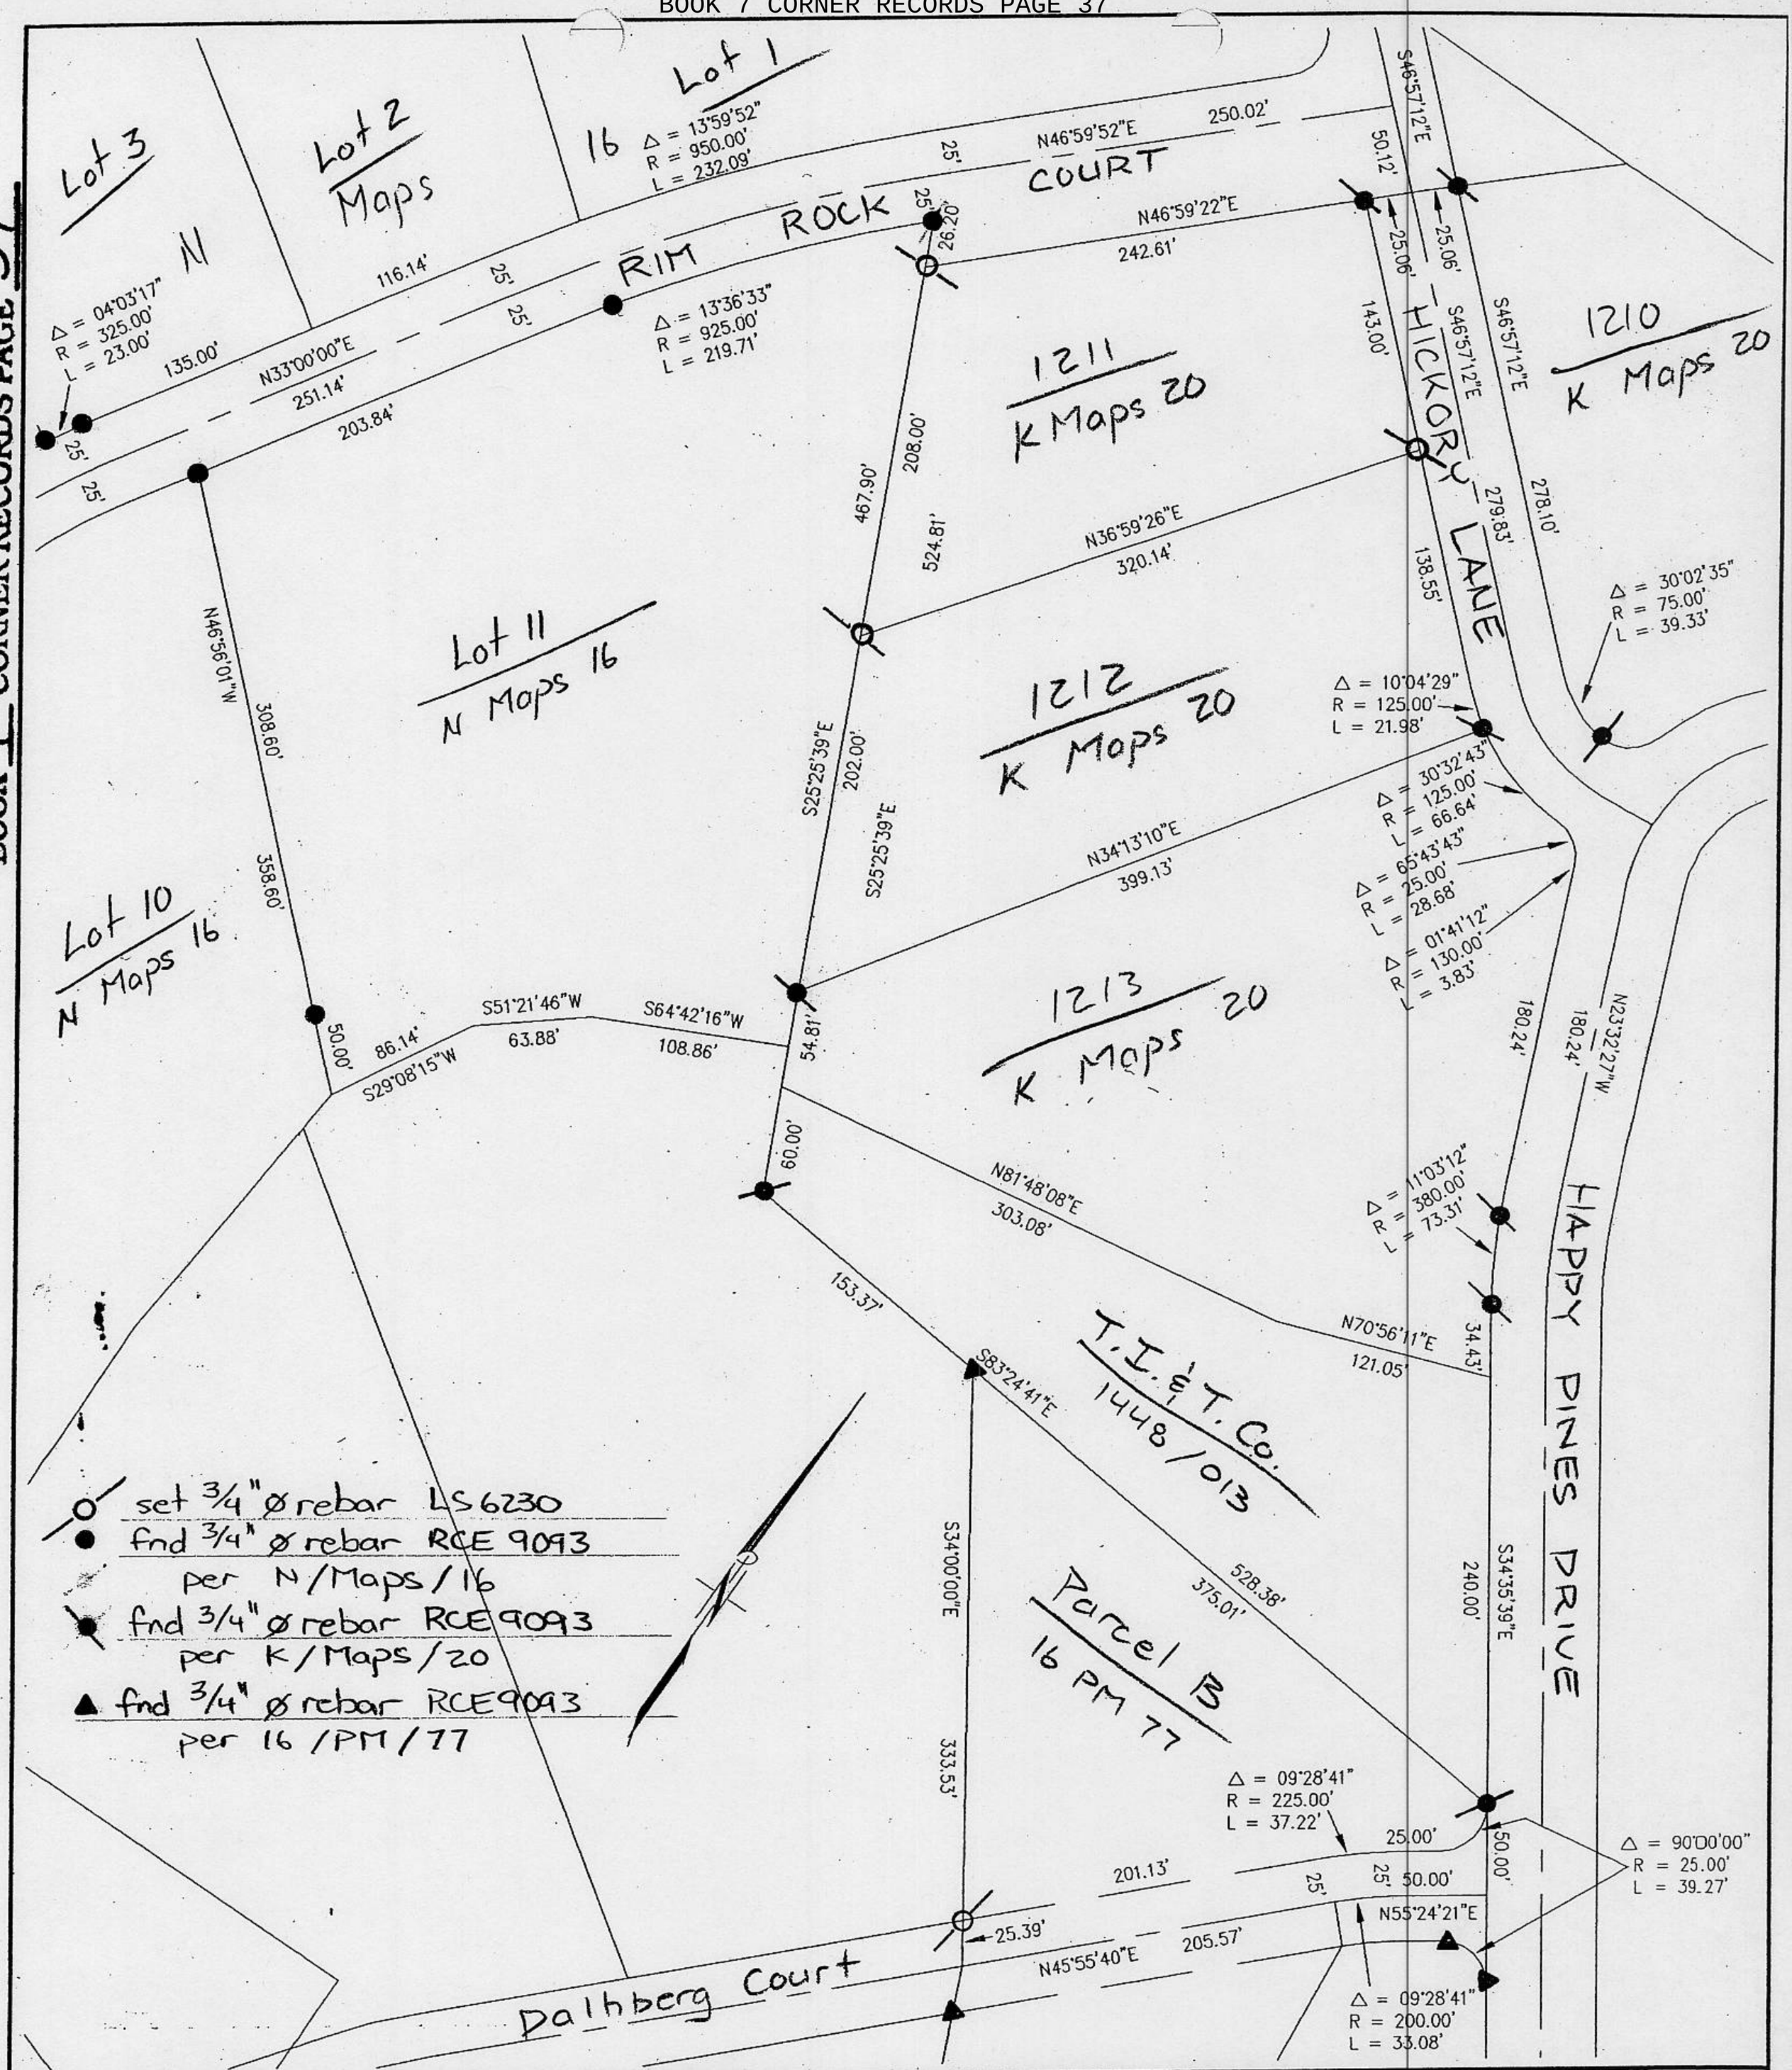

AUBURN SURVEYORS
POST OFFICE BOX 3296
AUBURN, CALIFORNIA 95604
ph: 530/889-2121
fx: 530/889-2632

PLAT OF SURVEY

IN SECTION 18, TOWNSHIP 13 NORTH, RANGE 10 EAST, M.D.M.
COUNTY OF PLACER STATE OF CALIFORNIA
DECEMBER 2001 SCALE 1" = 120'