CORNER RECORD

COUNTY OF PLACER, CALIFORNIA

City of _____ Document Number _____

Brief Legal Description T.17 N., R.14E. M.D.M. Lot 6, Blk. L, Ice Lakes U. No. 2 Bk. G Maps Pg. 1

CORNER TYPE

Government Corner ☐ Control ☐
Meander ☐ Property ☒
Rancho ☐ Other ☐
Date of Survey July 1, 2003

COORDINATES *(Optional)*

N. _____
E. _____
Zone _____ Datum _____
Elev. _____

Corner — Left as found ☐ Found and tagged ☐ Established ☐ Reestablished ☒ Rebuilt ☐

Identification and type of corner found: Evidence used to identify or procedure used to establish or reestablish corner:
Traver sed through the corners shown as found on the sketch. All fit their record positions well. Reestablished the 2 corners at their record positions.

A description of the physical condition of the monument as found and as set or reset: Set 3/4" rebars with LS 6350 tags attached.

BOOK 8 CORNER RECORDS PAGE 76

SURVEYOR'S STATEMENT

This Corner Record was prepared by me or under my direction in conformance with the Land Surveyors' Act on Nov. 7, 2003 ~~19~~ ____.

Signed David W. Graebner LS or R.C.E. Number LS 5350

LICENSED LAND SURVEYOR DAVID W. GRAEBNER No. LS 6350 Exp. 12/31/06 SEAL STATE OF CALIFORNIA

COUNTY SURVEYOR'S STATEMENT

This Corner Record was received NOV 14TH 2003 ~~19~~ ____ and examined and filed Nov. 24 2003 ~~19~~ ____.

Signed Charles B. Grant LS 6158 Title DEPUTY COUNTY SURVEYOR

LICENSED LAND SURVEYOR CHARLES B. GRANT Exp. 3-31-06 No. 6158 STATE OF CALIFORNIA

County Surveyor's Comment _____

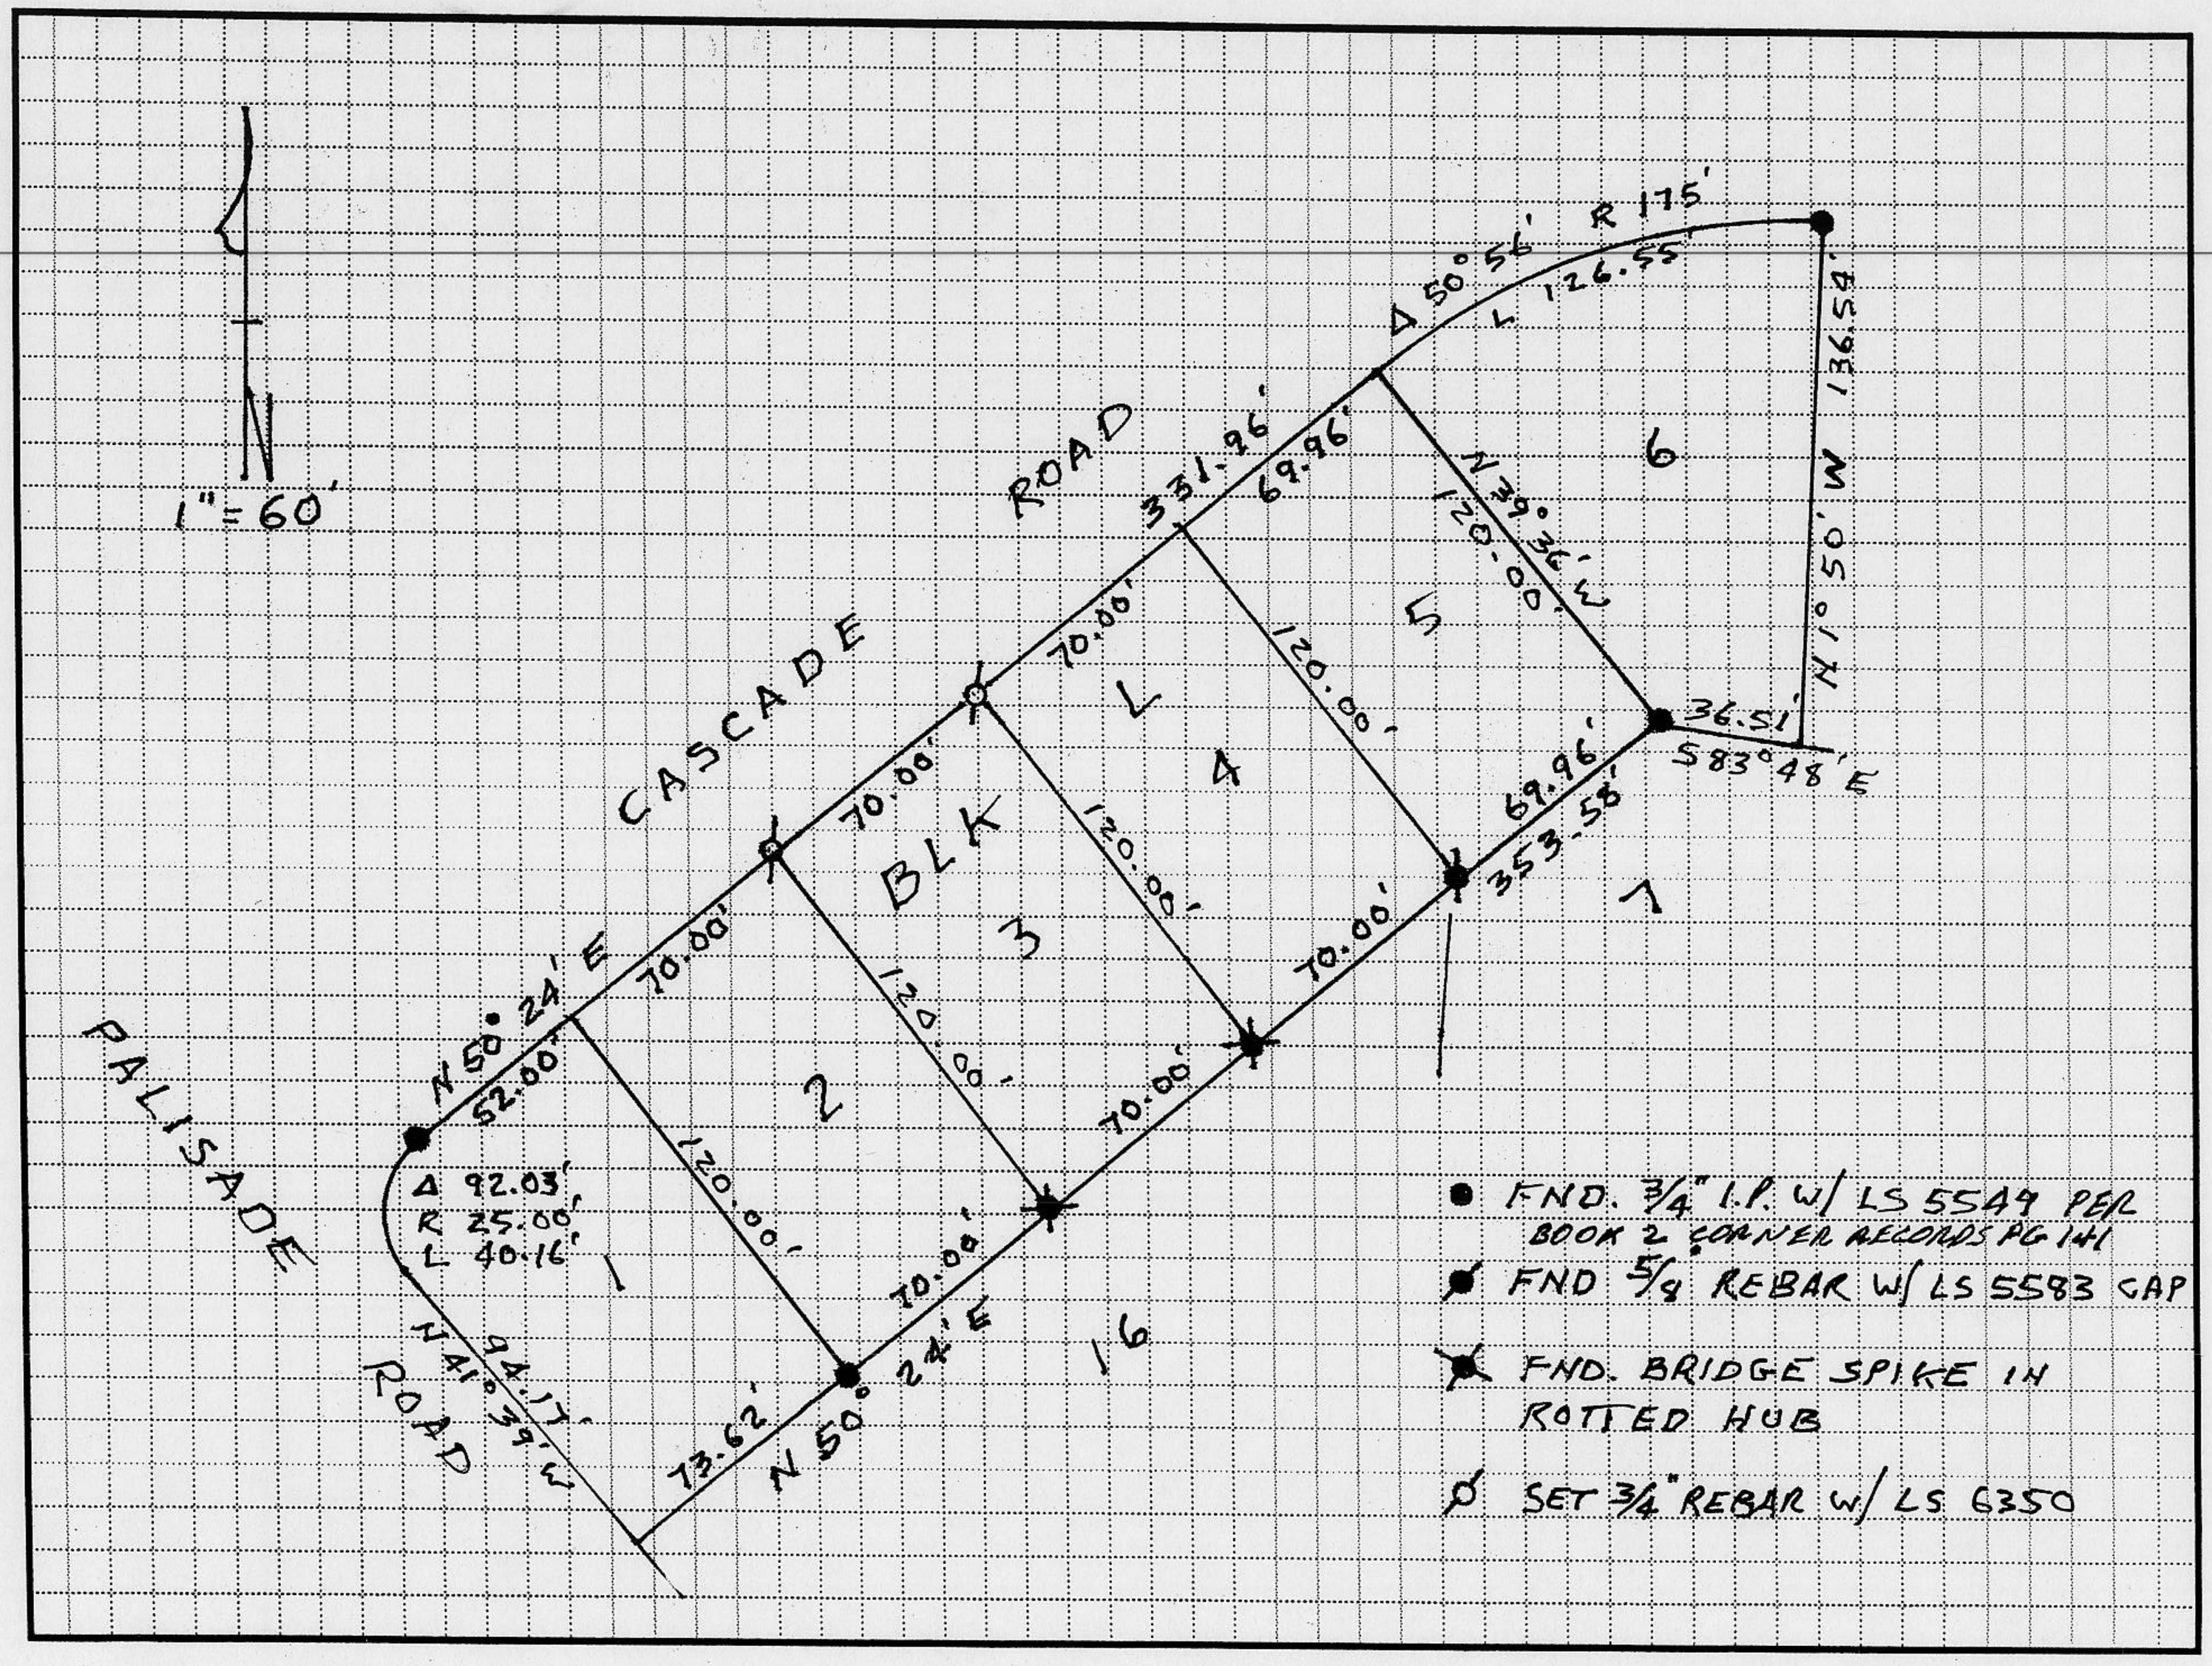
N
1" = 60'
CASCADE ROAD
PALISADE ROAD
BLK L
1
2
3
4
5
6
Δ 50°56' R 175' L 126.55'
331.96'
69.96'
N 39°36' W 120.00'
H 1°50' W 136.59'
36.51'
S 83°48' E
69.96'
353.58'
70.00'
120.00'
N 50°24' E 52.00'
Δ 92.03' R 25.00' L 40.16'
N 41°39' W 94.17'
73.62'
N 50°24' E
● FND. 3/4" I.P. W/ LS 5549 PER BOOK 2 CORNER RECORDS PG 141
● FND 5/8 REBAR W/ LS 5583 CAP
✕ FND. BRIDGE SPIKE IN ROTTED HUB
Ø SET 3/4" REBAR W/ LS 6350